IREDELL COUNTY HEALTH DEPARTMENT

Statesville Office (704) 878-5305 Mooresville Office (704) 660-3625

204327

PERMIT # 181062

IMPROVEMENT PERMIT / AUTHORIZATION TO CONSTRUCT / OPERATION PERMIT / EXISTING SYSTEM

PIN # 4705977973

APPLICANT: Clayton Homes APPLICANT ADDRESS: 2026 Northside Dr.

SITE ADDRESS: 165 Village Point Dr. PHONE: 704-239-3693 ALT. PHONE: N/A

SITE DIRECTIONS: Hwy 90 W TL Village Point Dr. Property on Left just passed Heartwood Ln.

SUBDIVISION: Village Point SECTION: N/A LOT # 4 LOT AREA: 0.57 acres DESIGN FLOW: 360gpd L.T.A.R.: 0.3


Septic Tank	1000 (gal)	STB	760	Date	3-28-14	☐ New System ☐ Repair ☐ Expansion	System Type: I II III IV V VI
Pump Tank	N/A (gal)	PT	N/A	Date	N/A	System Description:	25% Reduction
Pump Make	N/A	Model	Poly Tank	Serial #	PL-68	Repair System Description:	50% Reduction
# Nitrification Fields	1	# Lines	3	Linear Ft:	300	Maintenance Agreement Required:	☐ YES ☑ NO
Trench Width	36"	Max. Trench Bottom Depth	36"	Gravel Depth	N/A	☑ GRAVITY	☐ PRESSURE

☑ Residence No. Bedrooms 3
☐ Business No. Persons 6
☐ Other No. Employees
☐ Slab ☑ Crawl Space
☐ Basement w/plumbing ☐ Basement w/o plumbing

Water Supply: ☐ Private ☑ Public ☐ Community

Comments / Conditions: Install a 25% Reduction system on contour with serial distribution. Install a surface diversion ditch at location shown below.

INITIAL SITE SKETCH

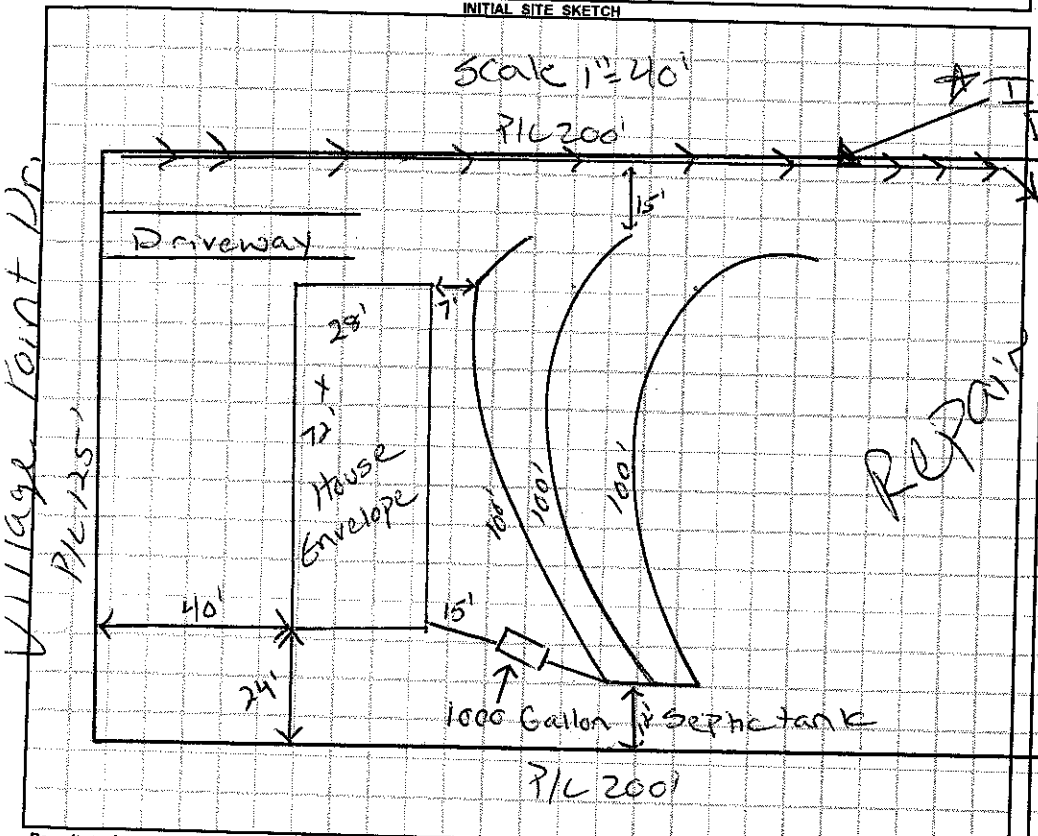

AS BUILT SKETCH

Installed Arc 36 as drawn

Permit can be suspended or revoked if any false information is supplied toward securing the permit / any unauthorized changes are made to the site / any unauthorized changes are made in the installation of the system. **CONTACT A LOCATOR SERVICE PRIOR TO ANY EXCAVATION**

☐ **IMPROVEMENT PERMIT** *with plat valid without expiration.* ☑ **IMPROVEMENT PERMIT** *with site plan valid for 60 mos.* ☑ **AUTHORIZATION TO CONSTRUCT** *valid for period equal to IMPROVEMENT PERMIT--not to exceed 60 mo.*

Owner / Applicant Signature: Deena Abee Date: 6/12/14 Installed by: Abee Grading

IMPROVEMENT PERMIT by: Justin Henderson Date: 6-6-14 OPERATION PERMIT by: Date: 07/17/14

AUTHORIZATION TO CONSTRUCT by: Justin Henderson Date: 6-6-14 Existing System Inspected by: Date:

Health Dept. Copy - WHITE Applicant (Final Approval) - YELLOW Applicant (Conditional Approval) - PINK