$130

IREDELL COUNTY HEALTH DEPARTMENT

STATESVILLE 704-878-5305 (C1) MOORESVILLE 704-664-5281

IMPROVEMENT PERMIT / AUTHORIZATION TO CONSTRUCT / OPERATION PERMIT / EXISTING SYSTEM INSPECTION

DATE 6/25/02

PERMIT# 106711 PIN# 4705978163

OWNER OR CONTRACTOR STONES EDGE INC PHONE: Business 663-2220 Home

ADDRESS 130 LAZY LANE MOORESVILLE

LOCATION 64W - TL LIPPARD FARM - TL STONES'EDGE - TL GEMSTONE - TR ZIRCON - TL TITANIUM - AT END ON RT.

SUBDIVISION STONES EDGE BLOCK / SECTION LOT 75 LOT AREA .649AC SITE CLASS PS DESIGN FLOW 360GPD L.T.A.R. .3GPD/FT2

Septic Tank: 1000 Gallons; STB 1012 Date 2-27-02
Pump Tank: Gallons; PT Date
Pump Make: Model Serial No.
Nitrification Field: No Fields 1 Square Feet 900 Linear Feet 300
No Lines 3@100' Trench Width 36" Max Trench Bottom Depth 36" Gravel Depth N/A

☑ New System ☐ Repair System Type: I, II, (III), IV, V, VI
System Description: GRAVITY 25% REDUCTION
Repair System Description: SAME GRAV./PUMP
Maintenance Agreement Required: ☐ Yes ☑ No

☑ House/Mod. Home ☐ Mobile Home ☐ Business ☐ Other
No. Bedrooms 3 No. Bathrooms 3 No. Employees


Water Supply: ☐ Individual ☑ Public ☐ Community

☐ Slab ☑ Crawl Space ☐ Basement w/plumbing ☐ Basement wo/plumbing

Comments:/Conditions:

Comments:/Conditions: SEPTIC TANK WITH MARKER INSTALLED USING "POLYLOK" FILTER

INITIAL SITE SKETCH 1" = 50'

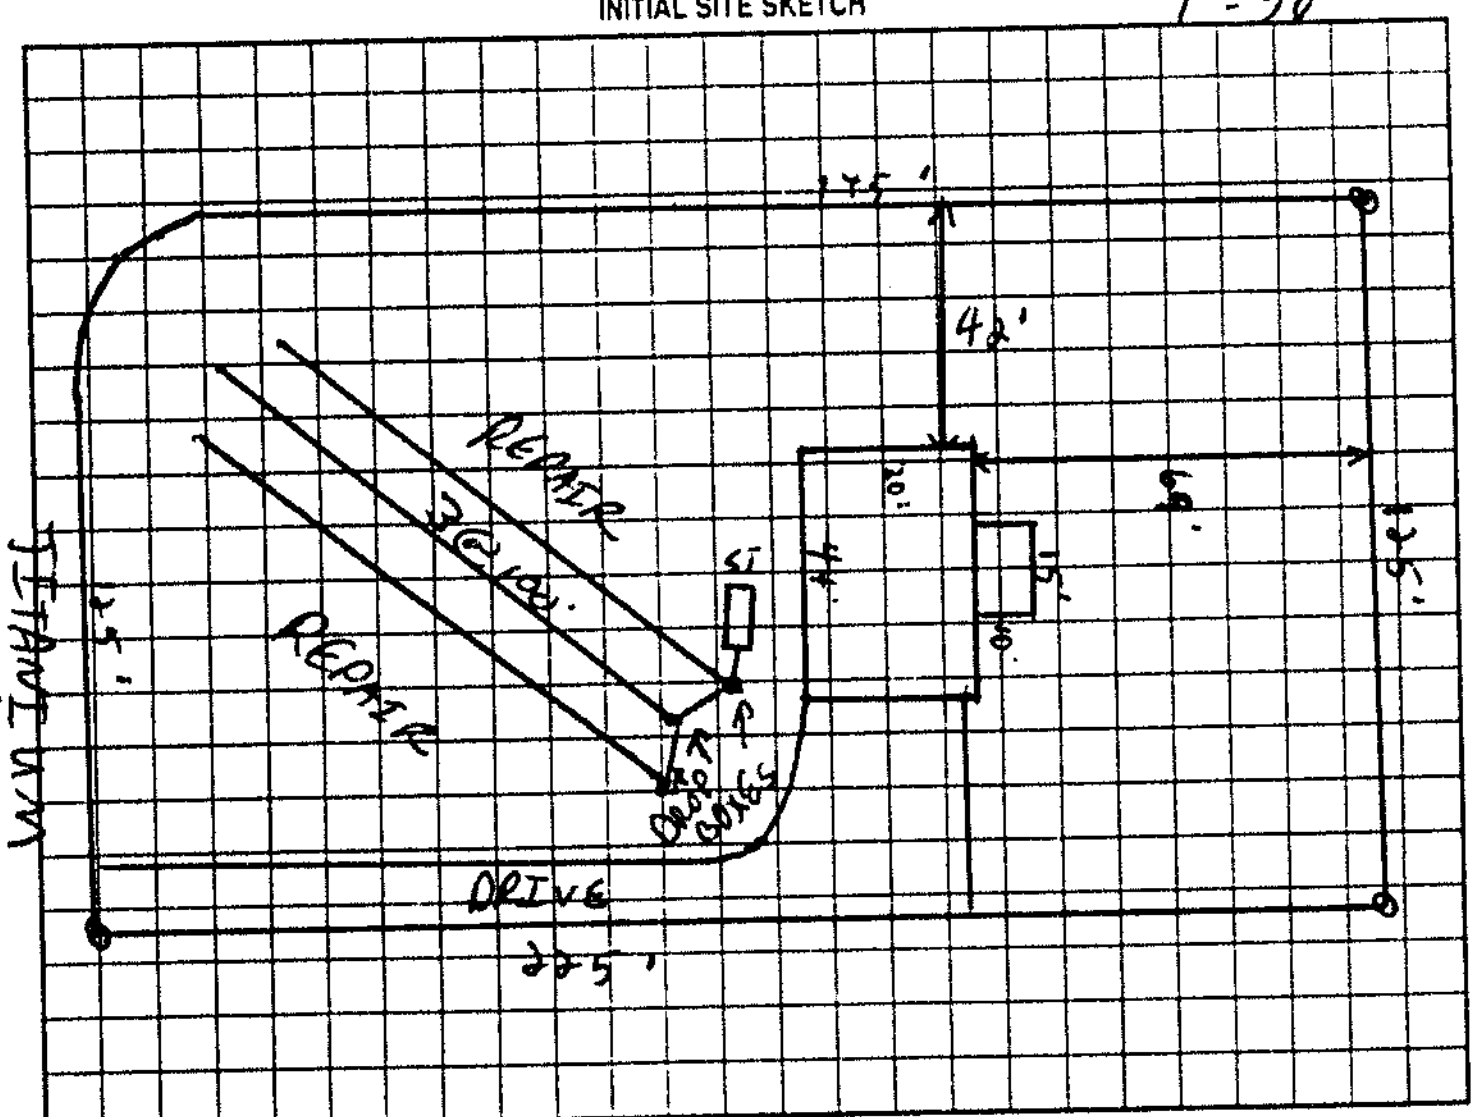

AS BUILT SKETCH

SYSTEM INSTALLED ACCORDING TO INITIAL SITE SKETCH USING FIFTY (50) INFILTRATOR CHAMBERS

Permit can be suspended or revoked if any false information is supplied toward securing the permit/any unauthorized changes are made to the site/any unauthorized changes are made in the installation of the system. Improvement Permit with plat valid without expiration. Improvement Permit with site plan valid for sixty months. Authorization to Construct is valid for a period equal to that of Improvement Permit - not to exceed sixty months.

Signed: date

Improvement Permit by: [signature] RS date 6/25/02

Authorization to Construct by: [signature] RS date 6/25/02

Installed by: CRAIG THOMPSON

Operation Permit by: STEVE HEDRICK date 7-12-02

Existing System Inspection by: date

HEALTH DEPT COPY WHITE OWNER COPY (FINAL) YELLOW OWNER COPY (INITIAL) PINK