IREDELL COUNTY HEALTH DEPARTMENT

STATESVILLE 704-878-5305 MOORESVILLE 704-664-5281

IMPROVEMENT PERMIT / AUTHORIZATION TO CONSTRUCT / OPERATION PERMIT / EXISTING SYSTEM INSPECTION

PERMIT# 091583 PIN# 4705 988 127 (pt) DATE October 10, 00

OWNER OR CONTRACTOR Allied Partners PHONE: Business 871-1536 Home

ADDRESS 310 Treebark Rd. Statesville 28687

LOCATION 90 West. TL just past Griffin HWY onto Village Point Drive on left

SUBDIVISION Village Point BLOCK / SECTION LOT 3 LOT AREA .57Ac SITE CLASS PS DESIGN FLOW 360gpd L.T.A.R. n.25

Septic Tank: 1000 Gallons; STB $21 Date 4-17-01

Pump Tank: Gallons; PT Date

Pump Make: Model Serial No.

Nitrification Field: No Fields 1 Square Feet 1080 Linear Feet 360

No Lines 4 Trench Width 36" Max Trench Bottom Depth 36" Gravel Depth NA

☑ New System ☐ Repair System Type: I, II, III, IV, V, VI

System Description: Gravity Innovative 25% Red.

Repair System Description: Gravity pumped Innovative or

Maintenance Agreement Required: ☐ Yes ☑ No Final/Back

☑ House/Mod. Home No. Bedrooms 3

☐ Mobile Home No. Bathrooms 2

☐ Business No. Employees

☐ Other


☐ Slab ☑ Crawl Space ☐ Basement w/plumbing ☐ Basement wo/plumbing

Water Supply: ☐ Individual ☑ Public ☐ Community


Comments/Conditions: Install Laterals between 30"-36" trench Bottom Depth. Follow contour with laterals as shown.

Comments/Conditions: 24x68 Mod. House in same location. Used Septic Tank marker. Installed 3 6-10ft Sections of HDES Pipe Polylok Filter Installed

1"=50' INITIAL SITE SKETCH

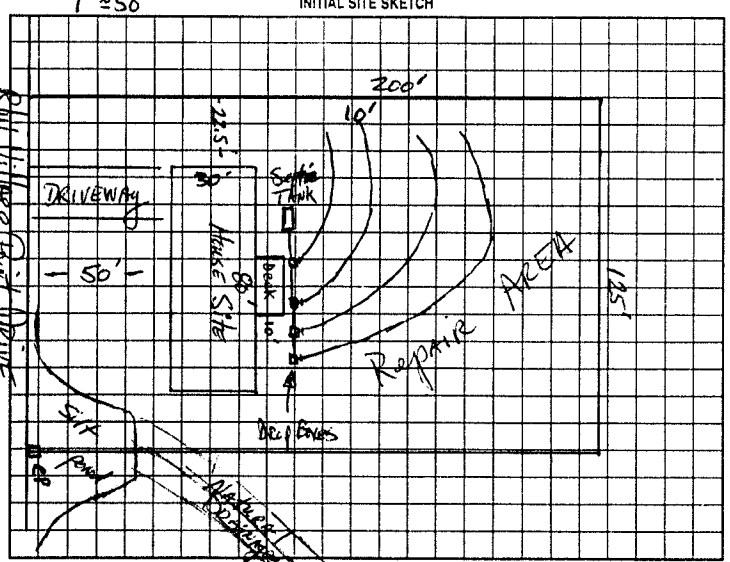

AS BUILT SKETCH 5 lines

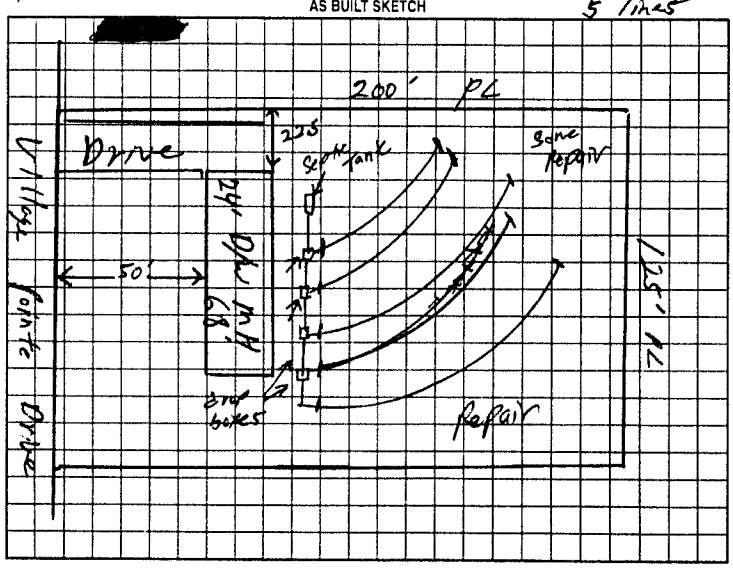

Permit can be suspended or revoked if any false information is supplied toward securing the permit/any unauthorized changes are made to the site/any unauthorized changes are made in the installation of the system. Improvement Permit with plat valid without expiration. Improvement Permit with site plan valid for sixty months. Authorization to Construct is valid for a period equal to that of Improvement Permit – not to exceed sixty months.

Signed: date

Improvement Permit by: date 10-10-00

Authorization to Construct by: RSI date 4-26-01

Installed by: Aime Grading Ind.

Operation Permit by: William E. Johnson date 5/29/01

Existing System Inspection by: date

HEALTH DEPT. COPY: WHITE OWNER COPY (FINAL): YELLOW OWNER COPY (INITIAL): PINK