Allied Partners LLC

THIS PERMIT REPLACES PREVIOUS ISSUED 4-9-2005

IREDELL COUNTY HEALTH DEPARTMENT

(C1) STATESVILLE 704-878-5305 (P) MOORESVILLE 704-664-5281

IMPROVEMENT PERMIT / AUTHORIZATION TO CONSTRUCT / OPERATION PERMIT / EXISTING SYSTEM INSPECTION

PERMIT # 127042 PIN # 4705-98-0554 DATE 4-7-2009

OWNER or APPLICANT CLAYTON HOWES PHONE: Business 704-873-2547 Home:

OWNER or APPLICANT ADDRESS 2026 NORTHSIDE DRIVE,

LOCATION / DIRECTIONS NC 90 W, TL VILLAGE POINT DRIVE, 17TH LOT ON LEFT

SUBDIVISION VILLAGE POINT BLOCK / SECTION LOT # 13 LOT AREA 0.60 ACRE DESIGN FLOW 360 L.T.A.R. 0.30 GPD/FT2

Septic Tank 1000 Gallons: STB 760 Date 4-21-08
Pump Tank Gallons: P T Date
Pump Make Model Serial #
Nitrification Field No Fields 1 No Lines 4 Linear Feet 300
Trench Width 36" Max. Trench Bottom Depth 36" Gravel Depth NA

☑ New System ☐ Repair ☐ Expansion System Type I II (III) IV V VI
System Description: 25% REDUCTION GRAVITY
Repair System Description: 25% REDUCTION GRAVITY
Maintenance Agreement Required ☐ YES ☑ NO
☑ GRAVITY ☐ PRESSURE


☑ Residence No. Bedrooms 3
☐ Business No. Persons
☐ Other No. Employees
☐ Slab ☐ Crawl Space
☐ Basement w/plumbing ☐ Basement w/o plumbing

Water Supply: ☐ Private ☑ Public ☐ Community


Comments / Conditions: INSTALL 25% REDUCTION SYSTEM USING SERIAL DISTRIBUTION

Comments / Conditions

INITIAL SITE SKETCH

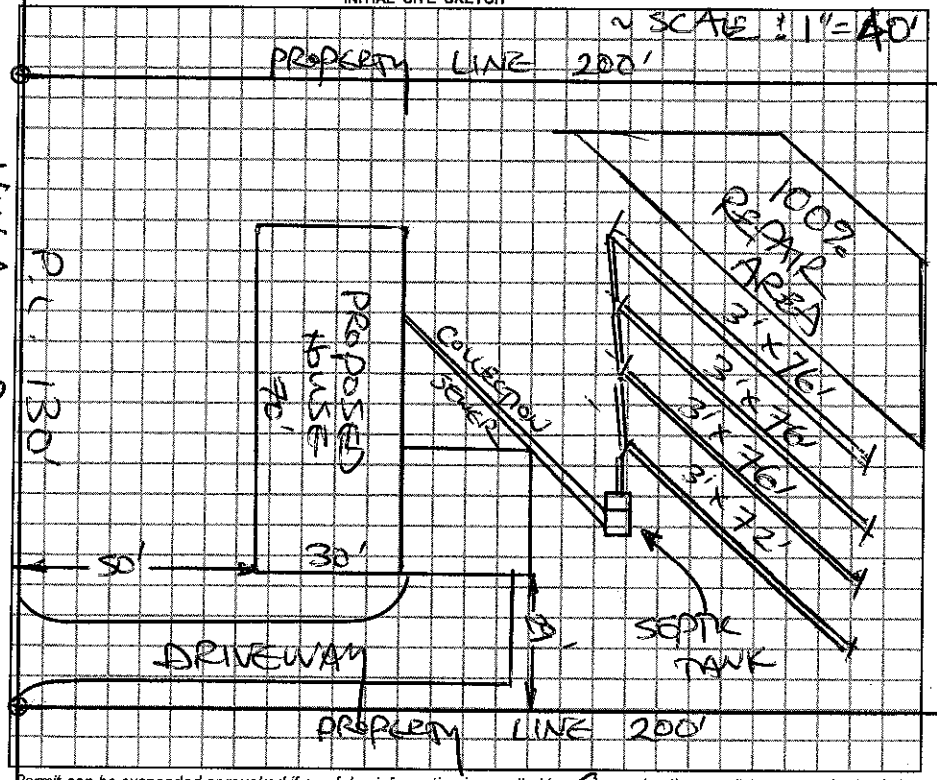

AS BUILT SKETCH

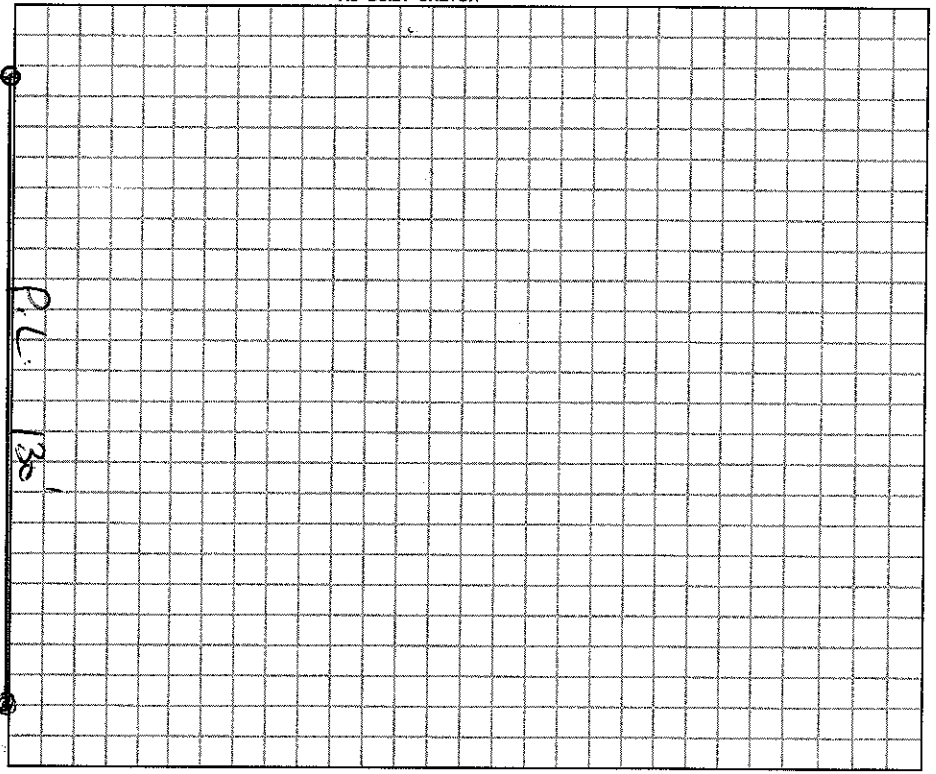

Permit can be suspended or revoked if any false information is supplied toward securing the permit / any unauthorized changes are made to the site / any unauthorized changes are made in the installation of the system.

☐ *IMPROVEMENT PERMIT w / plat valid without expiration.* ☑ *IMPROVEMENT PERMIT w / site plan valid for 60 mos.* ☐ *AUTHORIZATION TO CONSTRUCT valid for period equal to IMPROVEMENT PERMIT-not to exceed 60 mo.*

Owner / Applicant Signature: Date 4-7-09

Improvement Permit by: STEVE HEDRICK Date 4-7-2009

Authorization to Construct by: STEVE HEDRICK Date 4-7-2009

Installed by: A-1 Backhoe

Operation Permit by: Date: 4-8-2009

Existing System Inspected by: Date:

YOU SHOULD CONTACT A LOCATOR SERVICE PRIOR TO ANY EXCAVATION.

WHITE COPY Environmental Health YELLOW COPY (Final) Owner / Applicant PINK COPY (Initial) Owner / Applicant