IREDELL COUNTY HEALTH DEPARTMENT　　THIS PERMIT VOIDS PREVIOUS ISSUED 4-9-2005

STATESVILLE 704-878-5305　　MOORESVILLE 704-664-5281

IMPROVEMENT PERMIT / AUTHORIZATION TO CONSTRUCT / OPERATION PERMIT / EXISTING SYSTEM INSPECTION

PERMIT # 160798　　PIN # 4705-98-0870　　DATE MAY 12, 2010

OWNER or APPLICANT: CLAYTON HOMES of STATESVILLE　　PHONE: Business 704-873-2547　　Home:

OWNER or APPLICANT ADDRESS: 2026 NORTHSIDE DRIVE, STATESVILLE, NC 28625

LOCATION / DIRECTIONS: NC 90 WEST, TL VILLAGE POINT DRIVE, TR HEARTLAND DR, STRAIGHT AHEAD AT END.

SUBDIVISION: VILLAGE POINT　　BLOCK / SECTION:　　LOT # 15　　LOT AREA 0.57 Ac　　DESIGN FLOW 360　　L.T.A.R. 0.25 GPD/FT²

Septic Tank 1000 Gallons: STB 1000　　Date

Pump Tank　　Gallons: PT　　Date

Pump Make　　Model　　Serial #

Nitrification Field No Fields 1　　No Lines 6　　Linear Feet 360

Trench Width 36"　　Max. Trench Bottom Depth 36"　　Gravel Depth N/A

☒ GRAVITY　　☐ PRESSURE

☒ New System　☐ Repair　☐ Expansion System　　Type I II (III) IV V VI

System Description: 25% REDUCTION, GRAVITY

Repair System Description: 50% REDUCTION, LOW-PRESS

Maintenance Agreement Required　☐ YES　☒ NO

☒ Residence　　No. Bedrooms 3

☐ Business　　No. Persons

☐ Other　　No. Employees

☐ Slab　　☒ Crawl Space

☐ Basement w/plumbing　　☐ Basement w/o plumbing


Water Supply: ☐ Private　☒ Public　☐ Community

Comments / Conditions:

Comments / Conditions: + Biodiff. ARC 36　　+ Polylok Filter tee

site address 225 VILLAGE POINT DRIVE

INITIAL SITE SKETCH

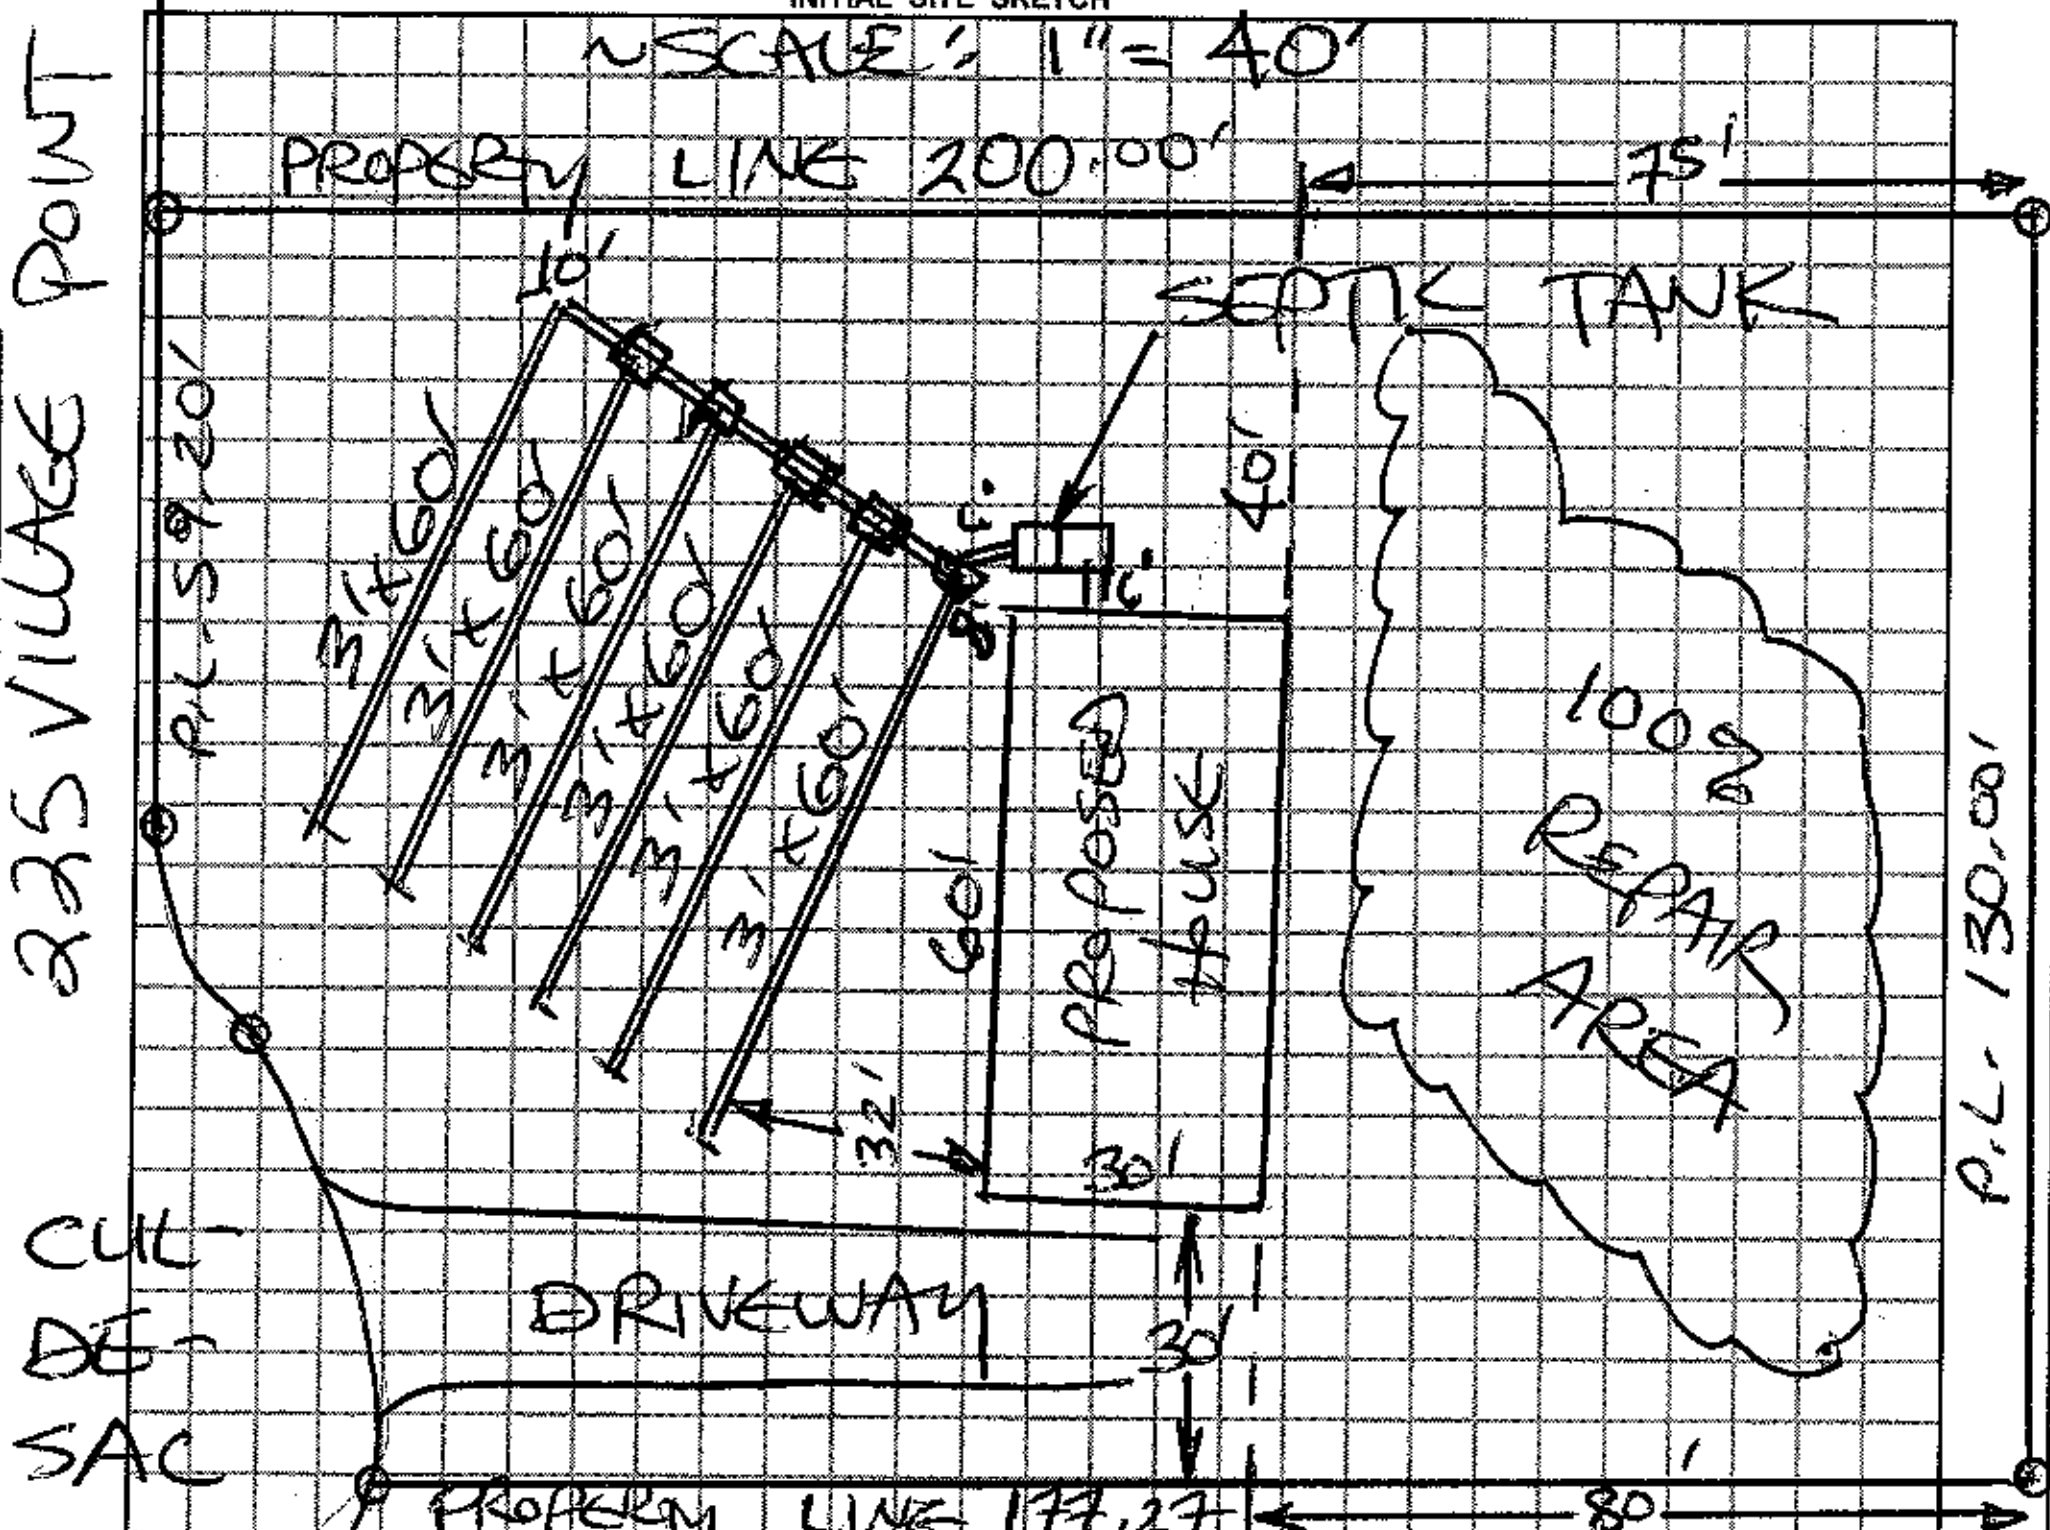

AS BUILT SKETCH

5 Drop-boxes used.

Installed as shown.

Permit can be suspended or revoked if any false information is supplied toward securing the permit / any unauthorized changes are made to the site / any unauthorized changes are made in the installation of the system.

☐ *IMPROVEMENT PERMIT w/ plat valid without expiration.*　☒ *IMPROVEMENT PERMIT w / site plan valid for 60 mos.*　☒ *AUTHORIZATION TO CONSTRUCT valid for period equal to IMPROVEMENT PERMIT-not to exceed 60 mo.*

Owner / Applicant Signature: [signature]　　Date 5-13-10　　Installed by: Tim Abee

Improvement Permit by: STEVE HEDRICK　　Date 5-12-2010　　Operation Permit by: [signature], R.S.　　Date: 20 May 10

Authorzation to Construct by: STEVE HEDRICK　　Date 5-12-2010　　Existing System Inspected by:　　Date:

YOU SHOULD CONTACT A LOCATOR SERVICE PRIOR TO ANY EXCAVATION.

WHITE COPY Environmental Health　　YELLOW COPY (Final) Owner / Applicant　　PINK COPY (Initial) Owner / Applicant