This Permit Voids previously issued permit dated 7/9/04

IREDELL COUNTY HEALTH DEPARTMENT

STATESVILLE 704-878-5305 CI MOORESVILLE 704-664-5281

IMPROVEMENT PERMIT / AUTHORIZATION TO CONSTRUCT / OPERATION PERMIT / EXISTING SYSTEM INSPECTION

PERMIT# 104196 PIN# 4705-98-~~0944~~ 0994 DATE

OWNER OR CONTRACTOR Heartwood Homes PHONE: Business (704) 460-7019 Home (704) 872-4641

ADDRESS 1270 North Side Drive Statesville N.C. 28625

LOCATION Hwy 90 West @ Village Point Drive @ Ent on left in cul-de-sac

SUBDIVISION Village Point BLOCK / SECTION LOT 16 LOT AREA .66 Acres SITE CLASS. P5 DESIGN FLOW 480 L.T.A.R. .25 gpd/ft²

Septic Tank: 1000 Gallons; STB 1012 Date 4-12-04
Pump Tank: Gallons; PT Date
Pump Make: Model Serial No.
Nitrification Field: No Fields 1 Square Feet 4 to 1920 Linear Feet 480
No Lines 7 Trench Width 36" Max Trench Bottom Depth 36" Gravel Depth NA

☒ New System ☐ Repair System Type: I, II, III, IV, V, VI
System Description: Gravity, 25% Reduction
Repair System Description: LP Panel Block
Maintenance Agreement Required: ☐ Yes ☒ No

☐ House/Mod. Home No. Bedrooms 4
☒ Mobile Home No. Bathrooms
☐ Business No. Employees
☐ Other


Water Supply: ☐ Individual ☒ Public ☐ Community

☐ Slab ☒ Crawl Space ☐ Basement w/plumbing ☐ Basement wo/plumbing


Comments:/Conditions: ① Install lines on Contour

Comments:/Conditions:
- Tuff Tite Filter & ST Marker Installed
- 77 Infiltrator Chambers Installed

INITIAL SITE SKETCH

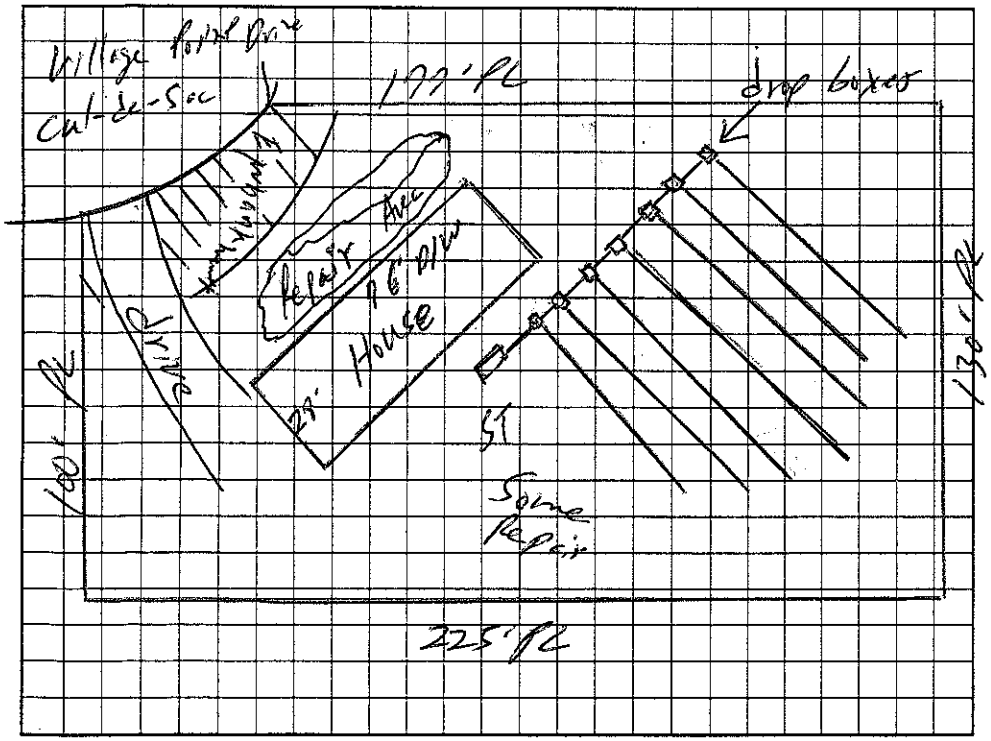

AS BUILT SKETCH

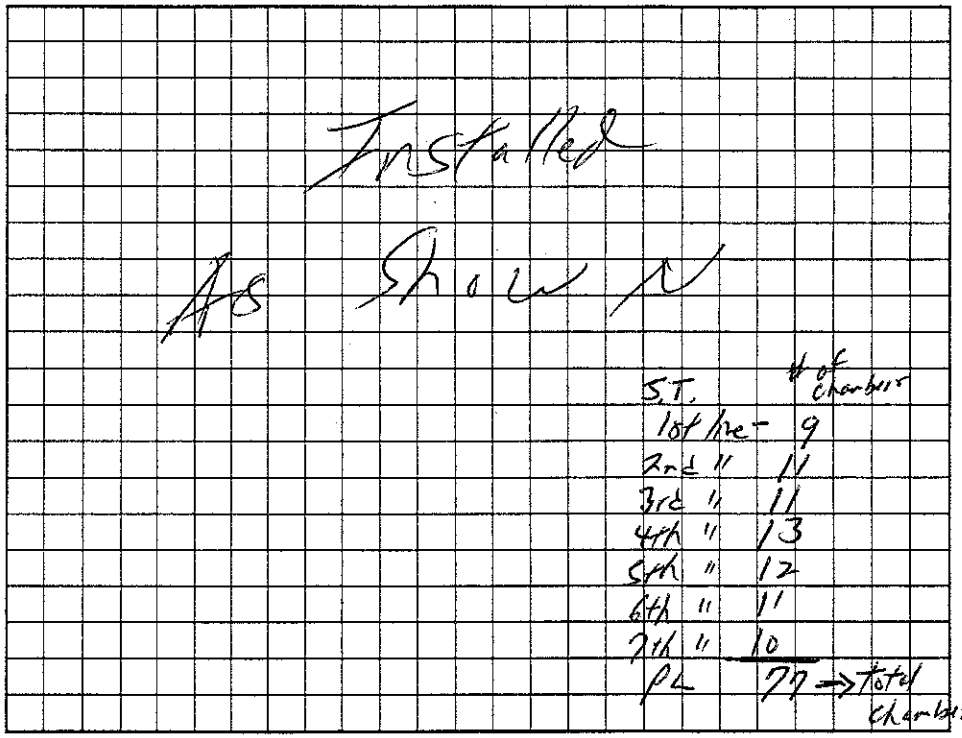

S.T.	# of chambers
1st line	9
2nd "	11
3rd "	11
4th "	13
5th "	12
6th "	11
7th "	10
PL	77 → Total chambers

Permit can be suspended or revoked if any false information is supplied toward securing the permit/any unauthorized changes are made to the site/any unauthorized changes are made in the installation of the system. Improvement Permit with plat valid without expiration. Improvement Permit with site plan valid for sixty months. Authorization to Construct is valid for a period equal to that of Improvement Permit – not to exceed sixty months.

Signed: date 8/31/04 Installed by: Craig Thompson

Improvement Permit by: William O. Johnson date 8/24/04 Operation Permit by: William O. Johnson date 8/26/04

Authorization to Construct by: William O. Johnson date 8/24/04 Existing System Inspection by: date

HEALTH DEPT. COPY: WHITE OWNER COPY (FINAL): YELLOW OWNER COPY (INITIAL): PINK