IREDELL COUNTY HEALTH DEPARTMENT - *ENVIRONMENTAL HEALTH* ☒ STATESVILLE OFFICE 704-878-5305 ☐ MOORESVILLE OFFICE 704-664-5281

IMPROVEMENT PERMIT / AUTHORIZATION TO CONSTRUCT / OPERATION PERMIT / EXISTING SYSTEM INSPECTION

PERMIT # 163969 PIN # 4705-98-3227 DATE 12-21-10

OWNER Hayden Investment APPLICANT: Clayton MH PHONE: Home/Cell # 704 941-5307 Business #

SITE ADDRESS 194 Village Point OWNER / APPLICANT ADDRESS 2026 Northside Drive

SITE DIRECTIONS Hwy 90 / 657 Village Point Drive - Lot on right

SUBDIVISION Village Point BLOCK / SECTION LOT # 41 LOT AREA .74 DESIGN FLOW 360 L.T.A.R. .25

Septic Tank 1000 Gallons: STB 960 Date 8-28-7

Pump Tank Gallons: P T Date

Pump Make Model Serial #

No. Nitrification Fields: 1 No. Lines 05 Linear Feet 360

Trench Width 36" Max. Trench Bottom Depth 36" Gravel Depth n/a

☒ New System ☐ Repair ☐ Expansion System Type I II (III) IV V VI

System Description: 25% Reduction Gravity

Repair System Description: 25% Reduction Gravity

Maintenance Agreement Required ☐ YES ☒ NO

☒ GRAVITY ☐ PRESSURE

☒ Residence No. Bedrooms 3

☐ Business No. Persons

☐ Other No. Employees

☐ Slab ☒ Crawl Space


☐ Basement w/plumbing ☐ Basement w/o plumbing

Water Supply: ☐ Private ☐ Public ☒ Community


Comments / Conditions

Polylock Filter

INITIAL SITE SKETCH

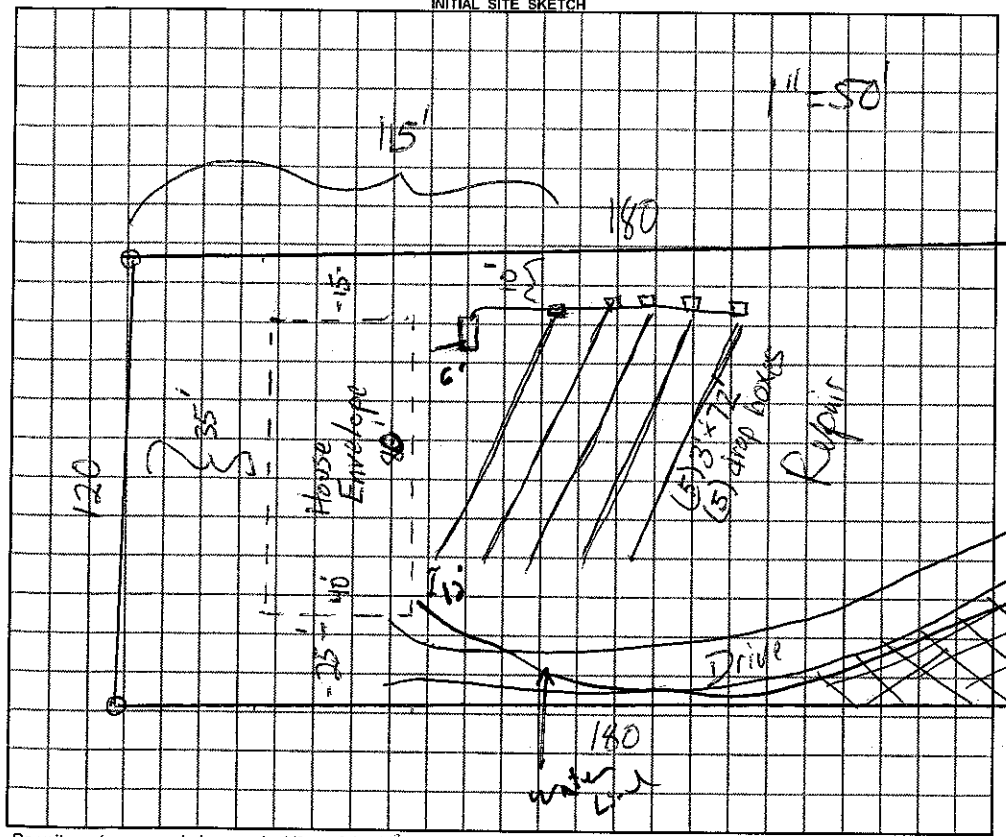

AS BUILT SKETCH

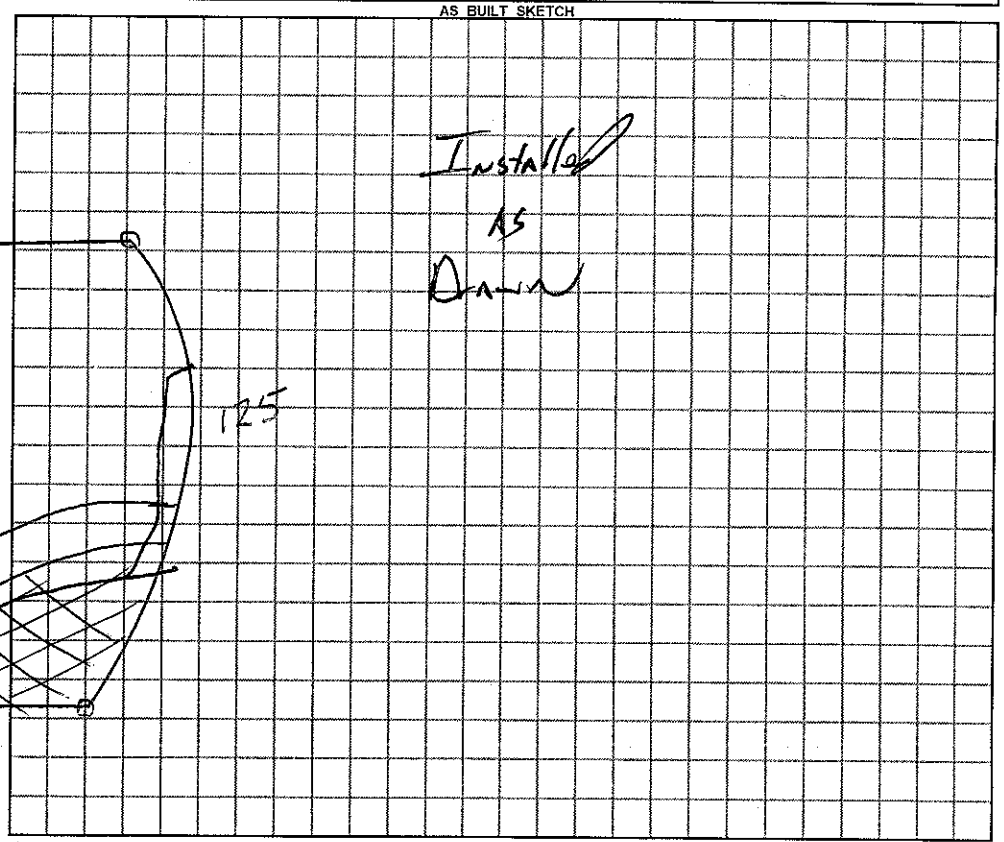

Permit can be suspended or revoked if any false information is supplied toward securing the permit / any unauthorized changes are made to the site / any unauthorized changes are made in the installation of the system.

☐ *IMPROVEMENT PERMIT* with plat valid without expiration. ☒ *IMPROVEMENT PERMIT* with plat valid ~~without expiration.~~ for 60 mos. ☒ *AUTHORIZATION TO CONSTRUCT* valid for period equal to IMPROVEMENT PERMIT--not to exceed 60 mo.

Owner / Applicant Signature: Date 12-28-10 Installed by: Tim Abee

IMPROVEMENT PERMIT by: REHS Date 12-21-10 OPERATION PERMIT by: REHS Date 18 JAN. 12

AUTHORIZATION TO CONSTRUCT by: REHS Date 12-28-10 Existing System Inspected by: REHS Date

YOU SHOULD CONTACT A LOCATOR SERVICE PRIOR TO ANY EXCAVATION

White Copy – Environmental Health YELLOW COPY (Final) Owner / Applicant PINK COPY (Initial) Owner / Applicant