New # 2011

IREDELL COUNTY HEALTH DEPARTMENT

STATESVILLE 704-878-5305 @ MOORESVILLE 704-664-5281

IMPROVEMENT PERMIT / AUTHORIZATION TO CONSTRUCT / OPERATION PERMIT / EXISTING SYSTEM INSPECTION

PERMIT# ~~04 329~~ 163775 PIN# 4705-98-4243 DATE 7/31/03

OWNER OR CONTRACTOR Allied Partners LLC PHONE: Business (704) ~~871-1536~~ 876-8600 Home —

ADDRESS 3/0 Tree bark Road Statesville N.C. 28625

LOCATION Hwy 90 W, L on Village Point Drive, on right past Heartwood Lane

SUBDIVISION Village Point BLOCK / SECTION — LOT 40 LOT AREA .67 Ac. SITE CLASS PS DESIGN FLOW 360 L.T.A.R. .30 gpd/ft²

Septic Tank: 4000 Gallons; STB 760 Date 2-17-10

Pump Tank: — Gallons; PT — Date —

Pump Make: — Model — Serial No. —

Nitrification Field: No Fields 1 Square Feet Equiv 2200 Linear Feet 300

No Lines 6 @ 50' Trench Width 36" Max Trench Bottom Depth 36" Gravel Depth NA

[X] New System [ ] Repair System Type: I, II, III, IV, V, VI

System Description: Gravity, 25% Reduction

Repair System Description: Pump, 25% Reduction

Maintenance Agreement Required: [ ] Yes [X] No

[ ] House/Mod. Home [X] Mobile Home [ ] Business [ ] Other

No. Bedrooms 3 No. Bathrooms 2 No. Employees —


[ ] Slab [X] Crawl Space [ ] Basement w/plumbing [ ] Basement wo/plumbing

Water Supply: [ ] Individual [X] Public [ ] Community


Comments:/Conditions: (1) Install lines on Contour (2) Install one (1) flow divider tee and (4) drop boxes for distribution of effluent

Comments:/Conditions: Pollock Filter Area

INITIAL SITE SKETCH

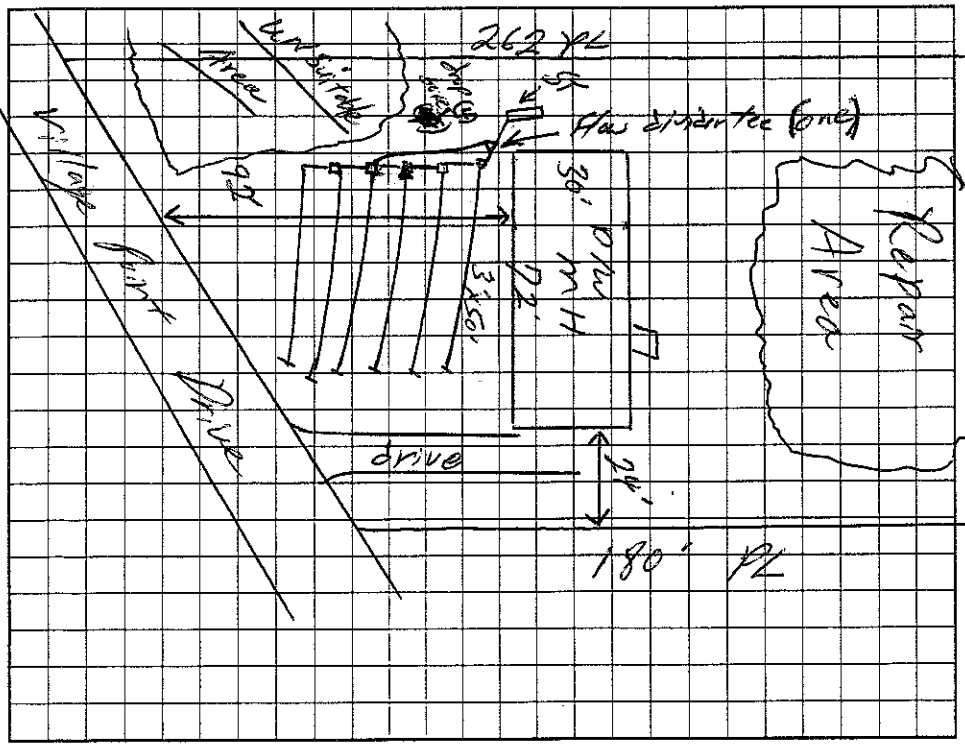

AS BUILT SKETCH

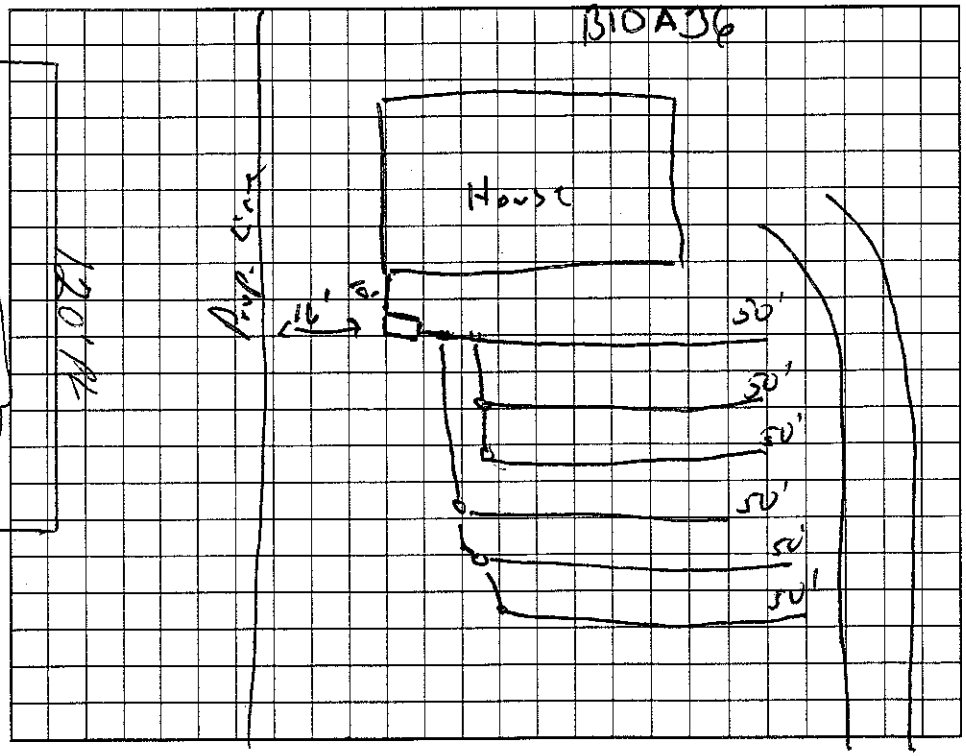

Permit can be suspended or revoked if any false information is supplied toward securing the permit/any unauthorized changes are made to the site/any unauthorized changes are made in the installation of the system. Improvement Permit with plat valid without expiration. Improvement Permit with site plan valid for sixty months. Authorization to Construct is valid for a period equal to that of Improvement Permit – not to exceed sixty months.

Signed: — date —

Improvement Permit by: William O Johnson date 7/31/03

Authorization to Construct by: RESERVE HENDRICK date 10/11/10

10-12-10

Installed by: Tim Abee

Operation Permit by: — R.S. date 29 Nov. 10

Existing System Inspection by: — date —

HEALTH DEPT. COPY: WHITE OWNER COPY (FINAL): YELLOW OWNER COPY (INITIAL): PINK