IREDELL COUNTY HEALTH DEPARTMENT

STATESVILLE 704-878-5305 (C1) MOORESVILLE 704-664-5281

IMPROVEMENT PERMIT / AUTHORIZATION TO CONSTRUCT / OPERATION PERMIT / EXISTING SYSTEM INSPECTION

PERMIT# 127044 PIN# 4705-98-5358 DATE 4-9-05

OWNER OR CONTRACTOR ALLIED PARTNERS, LLC PHONE: Business 704-902-4310 Home 704-876-8600

ADDRESS 310 TREEBARK ROAD, STATESVILLE NC 28625

LOCATION NC 90 WEST, TL VILLAGE POINT DRIVE, TR HEARTWOOD LANE, 4TH LOT ON LEFT

SUBDIVISION VILLAGE POINT BLOCK / SECTION ____ LOT 46 LOT AREA 0.55ACRE SITE CLASS PS DESIGN FLOW 480 L.T.A.R. 0.30 GPD/FT²

Septic Tank: 1000 Gallons; STB 1012 Date 9-20-04
Pump Tank: ____ Gallons; PT ____ Date ____
Pump Make: ____ Model ____ Serial No. ____
Nitrification Field: No Fields 1 Square Feet EQ-P 1600 Linear Feet 400
No Lines FOUR Trench Width 36" Max Trench Bottom Depth 36"

☒ New System ☐ Repair System Type: I, II, III, IV, V, VI
System Description: 25% REDUCTION, GRAVITY
Repair System Description: 50% REDUCTION, LOW PRESSURE
Maintenance Agreement Required: ☐ Yes ☒ No
Gravel Depth N/A


☒ House/Mod. Home No. Bedrooms 4
☐ Mobile Home No. Bathrooms ____
☐ Business No. Employees ____
☐ Other ____
☐ Slab ☒ Crawl Space ☐ Basement w/plumbing ☐ Basement wo/plumbing

Water Supply: ☐ Individual ☒ Public ☐ Community

Comments:/Conditions: INSTALL 25% REDUCTION SYSTEM ON CONTOUR AS SHOWN

Comments:/Conditions: SEPTIC TANK W/RISER MARKER INSTALLED USING "TUFTITE" FILTER

INITIAL SITE SKETCH

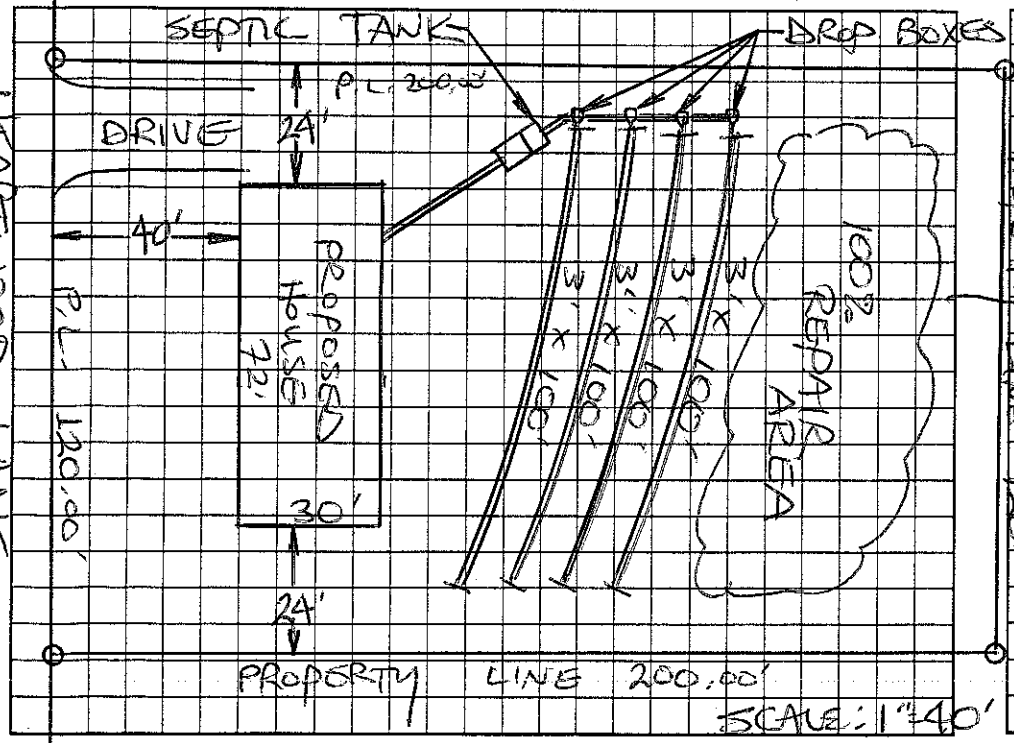

AS BUILT SKETCH

SYSTEM INSTALLED ACCORDING TO INITAL SITE SKETCH USING STANDARD "INFILTRATOR" CHAMBERS (64)

Permit can be suspended or revoked if any false information is supplied toward securing the permit/any unauthorized changes are made to the site/any unauthorized changes are made in the installation of the system. Improvement Permit with plat valid without expiration. Improvement Permit with site plan valid for sixty months. Authorization to Construct is valid for a period equal to that of Improvement Permit – not to exceed sixty months.

Signed: [signature] date 4-1005 Installed by: C & S GRADING

Improvement Permit by: STEVE HEDRICK date 4-9-05 Operation Permit by: STEVE HEDRICK date 4-27-05

Authorization to Construct by: STEVE HEDRICK date 4-21-05 Existing System Inspection by: ____ date ____

HEALTH DEPT. COPY: WHITE OWNER COPY (FINAL): YELLOW OWNER COPY (INITIAL): PINK