IREDELL COUNTY HEALTH DEPARTMENT

Statesville Office (704) 878-5305 Mooresville Office (704) 660-3625

IMPROVEMENT PERMIT / AUTHORIZATION TO CONSTRUCT / OPERATION PERMIT / EXISTING SYSTEM

PERMIT # 206500

APPLICANT: Hayday Investment LLC APPLICANT ADDRESS: 161 W Dodson Mill Rd Pilot Mtn NC

SITE ADDRESS: 119 Heartwood Lane PIN # 4705-98-6341

SITE DIRECTIONS: GO NC 901 West TL on Village Point Dr TR on Heartwood Lane 2nd lot on left PHONE: (704) 902-4659 ALT. PHONE: N/A

SUBDIVISION: Village Point SECTION: N/A LOT # 47 LOT AREA: .550 ac DESIGN FLOW: 480 L.T.A.R.: .3

Septic Tank	1000 (gal)	STB	760	Date	12-4-14
Pump Tank	N/A (gal)	PT	N/A	Date	N/A
Pump Make	N/A	Model	Poly Tank	Serial #	PL-65
# Nitrification Fields	1	# Lines	4	Linear Ft:	400
Trench Width	36"	Max. Trench Bottom Depth	36"		

☑ New System ☐ Repair ☐ Expansion System Type: I II III IV V VI

System Description: 25% reduction serial distrib

Repair System Description: LPP panel block

Maintenance Agreement Required: ☐ YES ☑ NO

Gravel Depth N/A ☑ GRAVITY ☐ PRESSURE

☑ Residence ☐ Business ☐ Other ☐ Slab ☐ Basement w/plumbing


No. Bedrooms 4 No. Persons 0 No. Employees ☑ Crawl Space

Water Supply: ☐ Private ☑ Public ☐ Community ☐ Basement w/o plumbing

Comments / Conditions: Keep 10' between water lines and any part of septic system or repair area(s) ~~NOTE: Begin Lines~~ are flagged 3 ft forward toward Heartwood Lane than shown on permit adjust drain line locations accordingly to match

permit. ~~for equal flow keep 100' between bottom of trench to bottom of trench~~

INITIAL SITE SKETCH

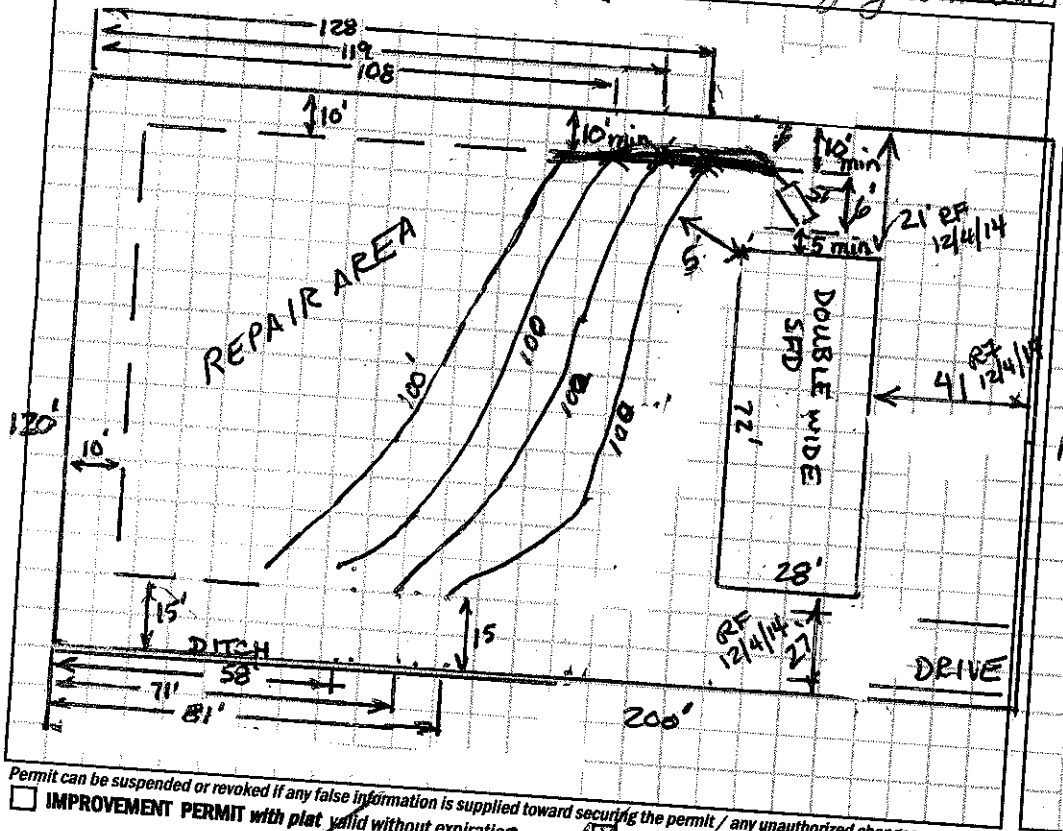

AS BUILT SKETCH

line lengths

~~actual measure~~	corrected if trench 4 is raised
~~92~~ 100'	~~88'~~
~~106~~ 100'	~~104~~
~~108~~ 100'	~~104~~
~~106~~ 100'	~~104~~
400' total	

Installed as drawn

Are 36 as drawn

Permit can be suspended or revoked if any false information is supplied toward securing the permit / any unauthorized changes are made to the site / any unauthorized changes are made in the installation of the system. CONTACT A LOCATOR SERVICE PRIOR TO ANY EXCAVATION

☐ IMPROVEMENT PERMIT with plat valid without expiration.

☑ IMPROVEMENT PERMIT with site plan valid for 60 mos.

☑ AUTHORIZATION TO CONSTRUCT valid for period equal to IMPROVEMENT PERMIT--not to exceed 60 mo.

Owner / Applicant Signature: [signature]

IMPROVEMENT PERMIT by: Richard Harris Date: 12/3/14

AUTHORIZATION TO CONSTRUCT by: Richard Harris Date: 12/2/14

Installed by: Abeds Clearing + Grading

OPERATION PERMIT by: [signature] Date: 12-19-14

Existing System Inspected by: Date:

Health Dept. Copy - WHITE Applicant (Final Approval) - YELLOW Applicant (Conditional Approval) - PINK