IREDELL COUNTY HEALTH DEPARTMENT

STATESVILLE 704-878-5305 CI MOORESVILLE 704-664-5281

IMPROVEMENT PERMIT / AUTHORIZATION TO CONSTRUCT / OPERATION PERMIT / EXISTING SYSTEM INSPECTION

CI

PERMIT# 105142 PIN# 4705-98-6633 DATE 10/22/02

OWNER OR CONTRACTOR Allied Partners LLC PHONE: Business (704) 871-1536 Home —

ADDRESS 310 Tree bark Rd Statesville N.C. 28625

LOCATION Hwy 90 W. @ Village Point, @ Heartwood Lot on @

SUBDIVISION Village Point BLOCK / SECTION — LOT 20 LOT AREA .574 SITE CLASS: S[redacted] DESIGN FLOW 360 L.T.A.R. .30 gpd/ft²

Septic Tank: 1,000 Gallons; STB 1012 Date 8-10-02

Pump Tank: — Gallons; PT — Date —

Pump Make: — Model — Serial No. —

Nitrification Field: No Fields 1 Square Feet 1200 Linear Feet 400

No Lines 4@100 Trench Width 36" Max Trench Bottom Depth 30" Gravel Depth 12"

☒ New System ☐ Repair System Type: I, II, III, IV, V, VI

System Description: Gravity, Conventional

Repair System Description: [redacted] Pump, 75% Red

Maintenance Agreement Required: ☐ Yes ☒ No

☐ House/Mod. Home ☒ Mobile Home ☐ Business ☐ Other

No. Bedrooms 3 No. Bathrooms 2 No. Employees —


☐ Slab ☒ Crawl Space ☐ Basement w/plumbing ☐ Basement wo/plumbing

Water Supply: ☐ Individual ☒ Public ☐ Community


Comments/Conditions: ① Install lines on Contour ② maintain proper setbacks

Comments/Conditions: - Tuff Tite Filter Installed - S.T. Marker Installed

INITIAL SITE SKETCH Not to Scale

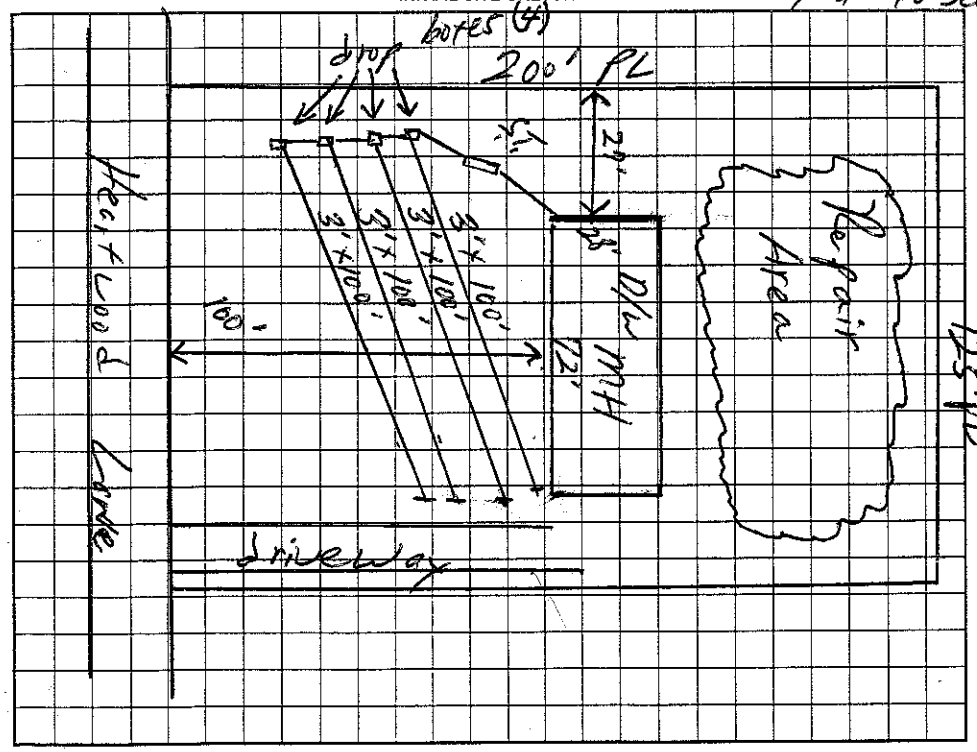

AS BUILT SKETCH

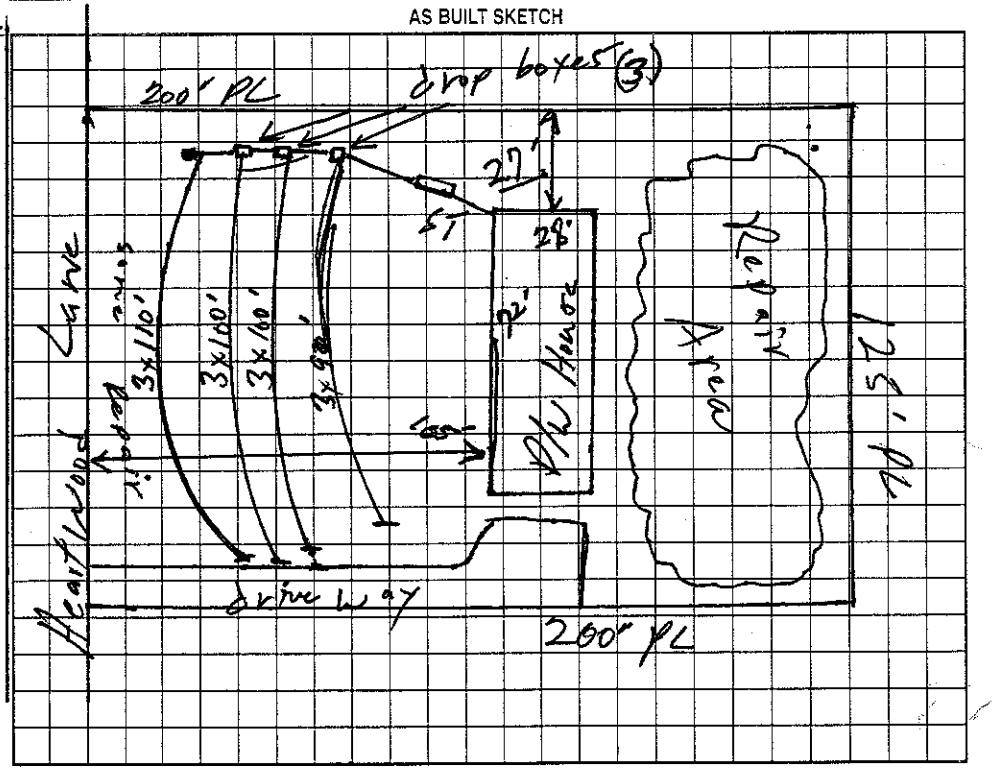

Permit can be suspended or revoked if any false information is supplied toward securing the permit/any unauthorized changes are made to the site/any unauthorized changes are made in the installation of the system. Improvement Permit with plat valid without expiration. Improvement Permit with site plan valid for sixty months. Authorization to Construct is valid for a period equal to that of Improvement Permit – not to exceed sixty months.

Signed: Dennis Dalton date 10-28 Installed by: A-1 Backhoe

Improvement Permit by: William O. Johnson date 10/22/02 Operation Permit by: William O. Johnson date 4/1/03

Authorization to Construct by: William O. Johnson date 10/22/02 Existing System Inspection by: — date —

HEALTH DEPT. COPY: WHITE OWNER COPY (FINAL): YELLOW OWNER COPY (INITIAL): PINK