IREDELL COUNTY HEALTH DEPARTMENT

STATESVILLE 704-878-5305 MOORESVILLE 704-664-5281

IMPROVEMENT PERMIT / AUTHORIZATION TO CONSTRUCT / OPERATION PERMIT / EXISTING SYSTEM INSPECTION

PERMIT# 102732 PIN# 4705-98-7233 DATE 10-17-01

OWNER OR CONTRACTOR MARY HAMILTON PHONE: Business Home (704) 872-6240

ADDRESS 2324 CUNE ST STATESVILLE, NC 28677

LOCATION NC 90 W, TL VILLAGE POINT DR, TR HEARTWOOD LANE, 2ND LOT ON LEFT

SUBDIVISION VILLAGE POINT BLOCK / SECTION LOT 48 LOT AREA 0.56 ACRE SITE CLASS PS DESIGN FLOW 300 L.T.A.R. 0.40 GPD/FT²

Septic Tank: 1000 Gallons: STB 1799 Date 1-13-02
Pump Tank: Gallons: PT Date
Pump Make: Model Serial No.
Nitrification Field: No Fields 1 Square Feet 900 Linear Feet 300
No Lines FOUR Trench Width 36" Max Trench Bottom Depth 36" Gravel Depth 12"

☑ New System ☐ Repair System Type: I (II) III. IV. V. VI
System Description: CONVENTIONAL GRAVITY
Repair System Description: CONV. GRAVITY
Maintenance Agreement Required: ☐ Yes ☐ No


☐ House/Mod. Home No. Bedrooms 3
☐ Mobile Home No. Bathrooms 2
☐ Business No. Employees
☐ Other
☐ Slab ☐ Crawl Space ☐ Basement w/plumbing ☐ Basement wo/plumbing

Water Supply: ☐ Individual ☑ Public ☐ Community


Comments:/Conditions:

Comments:/Conditions: - Zebel Filter Installed
- Septic Tank Marker Installed

INITIAL SITE SKETCH SCALE: 1"=40'

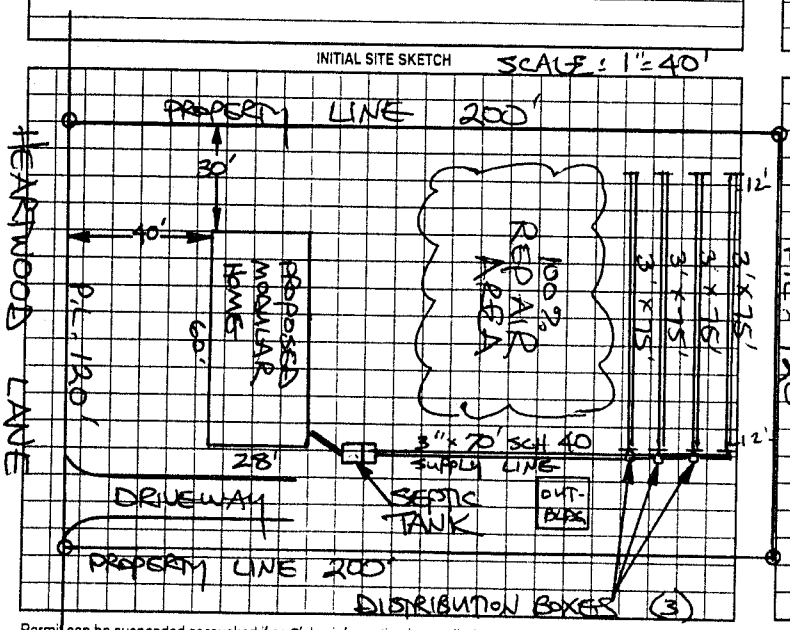

AS BUILT SKETCH

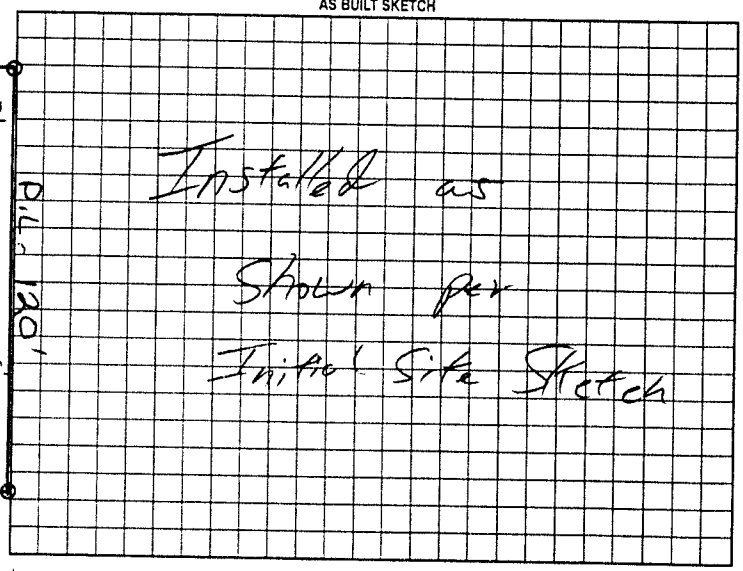

Permit can be suspended or revoked if any false information is supplied toward securing the permit/any unauthorized changes are made to the site/any unauthorized changes are made in the installation of the system. Improvement Permit with plat valid without expiration. Improvement Permit with site plan valid for sixty months. Authorization to Construct is valid for a period equal to that of Improvement Permit – not to exceed sixty months.

Signed: + Thomas Jeremy date 10-17-01 Installed by: Marty Tucker

Improvement Permit by: STEVE HEDRICK date 10-17-01 Operation Permit by: William G Johnson date 3/6/02

Authorization to Construct by: STEVE HEDRICK date 10-17-01 Existing System Inspection by: date

HEALTH DEPT COPY WHITE OWNER COPY (FINAL) YELLOW OWNER COPY (INITIAL) PINK