IREDELL COUNTY HEALTH DEPARTMENT

STATESVILLE 704-878-5305 MOORESVILLE 704-664-5281

IMPROVEMENT PERMIT / AUTHORIZATION TO CONSTRUCT / OPERATION PERMIT / EXISTING SYSTEM INSPECTION

PERMIT# 104202 PIN# 4705-98-7535 DATE 10/22/02

OWNER OR CONTRACTOR Allied Partners LLC PHONE Business (704) 871-1536 Home —

ADDRESS 310 Tree Lark Road Statesville N.C. 28625

LOCATION Hwy 90 W. @ Village Point, @ on Hartland or @

SUBDIVISION Village Point BLOCK / SECTION — LOT 21 LOT AREA .57 A. SITE CLASS P3 DESIGN FLOW 360 L.T.A.R. .30 gpd/ft²

Septic Tank: 1,000 Gallons. STB 1012 Date 07/01/02
Pump Tank: ____ Gallons. PT ____ Date ____
Pump Make: ____ Model ____ Serial No ____
Nitrification Field: No Fields 1 Square Feet 1200 Linear Feet 300'
No Lines 4@75 Trench Width 36" Max Trench Bottom Depth 30" Gravel Depth —

X New System Repair System Type I II III IV V VI
System Description Gravity 25% Reduction
Repair System Description Pump 25% Reduction
Maintenance Agreement Required. Yes X No

X Mobile Home No. Bedrooms 3
Business No. Bathrooms 2
Other No. Employees ____


Slab X Crawl Space Basement w/plumbing Basement wo/plumbing

Water Supply: ☐ Individual X Public ☐ Community


Comments/Conditions:

Comments/Conditions SEPTIC TANK INSTALLED USING MARKER + TUFF TIGHT FILTER.

INITIAL SITE SKETCH 1"=50'

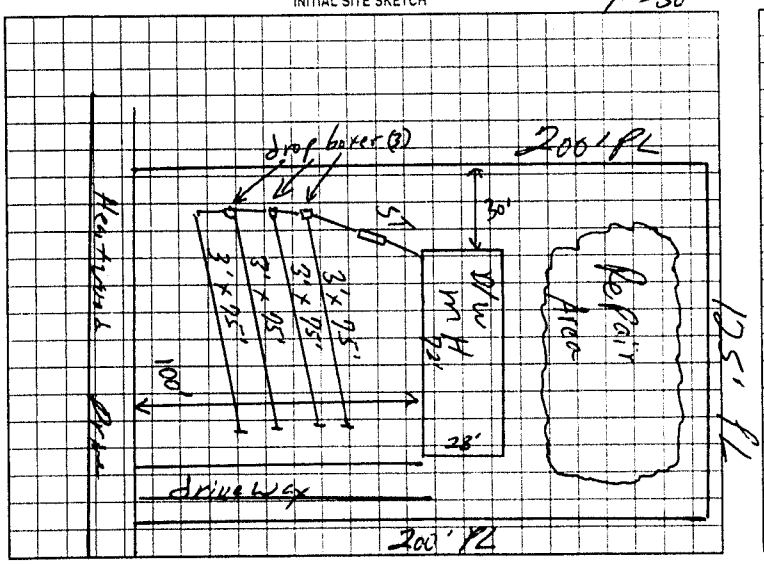

AS BUILT SKETCH

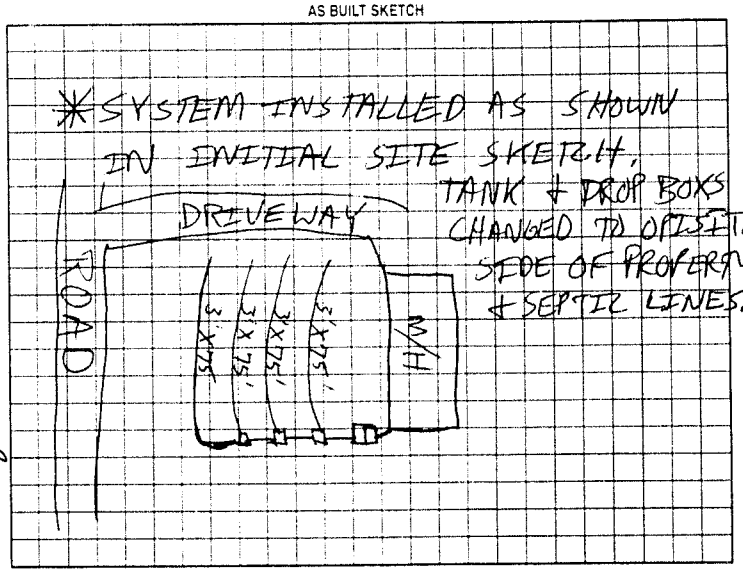

Permit can be suspended or revoked if any false information is supplied toward securing the permit; any unauthorized changes are made to the site; any unauthorized changes are made in the installation of the system. Improvement Permit with plat valid without expiration. Improvement Permit with site plan valid for sixty months. Authorization to Construct is valid for a period equal to that of Improvement Permit - not to exceed sixty months.

Signed: [signature] date 10-28 Installed by A-1 BACKHOE

Improvement Permit by: [signature] date 10/22/02 Operation Permit by [signature] date 11/26/02

Authorization to Construct by: [signature] date 10/22/02 Existing System Inspection by ____ date ____

HEALTH DEPT COPY WHITE OWNER COPY (FINAL) YELLOW OWNER COPY (INITIAL) PINK