Y HEALTH DEPARTMENT - ENVIRONMENTAL HEALTH ☑ STATESVILLE OFFICE 704-878-5305 ☐ MOORESVILLE OFFICE 704-664-5281

NT PERMIT ☑ / AUTHORIZATION TO CONSTRUCT ☑ / OPERATION PERMIT ☑ / EXISTING SYSTEM INSPECTION

575 PIN # 4705-98-8147 DATE 15 December 2011

dba/ Investments APPLICANT: Clayton Homes PHONE: Home/Cell # (704) 239-3693 Business #

107 Heartwood Ln. Stat. OWNER / APPLICANT ADDRESS

Hwy 90W Turn onto Village Point Dr. Corner of Heartwood & Village Point.

SUBDIV. Village Point BLOCK / SECTION LOT # 49 LOT AREA 0.56 Ac. DESIGN FLOW 360 gpd L.T.A.R. 0.3 gpd/ft²

Septic Tank 1000 gal Gallons: STB 760 Date 7-11-11 ☑ New System ☐ Repair ☐ Expansion System Type I II III IV V VI

Pump Tank Gallons: PT Date System Description: 25% Reduction

Pump Make Model Serial # Repair System Description: LPP 50% Reduction

No. Nitrification Fields: 1 No. Lines 3 Linear Feet 300 Maintenance Agreement Required ☐ YES ☑ NO

Trench Width 36" Max. Trench Bottom Depth 36" Gravel Depth NA ☑ GRAVITY ☐ PRESSURE

☑ Residence No. Bedrooms 3 Water Supply

☐ Business No. Persons ☐ Private

☐ Other No. Employees ☑ Public

☐ Slab ☑ Crawl Space ☐ Community

☐ Basement w/plumbing ☐ Basement w/o plumbing


Comments / Conditions Follow contour / Keep out of headslope area

Polylock Fittings. ST MARKER.


INITIAL SITE SKETCH

1" = 60'

AN

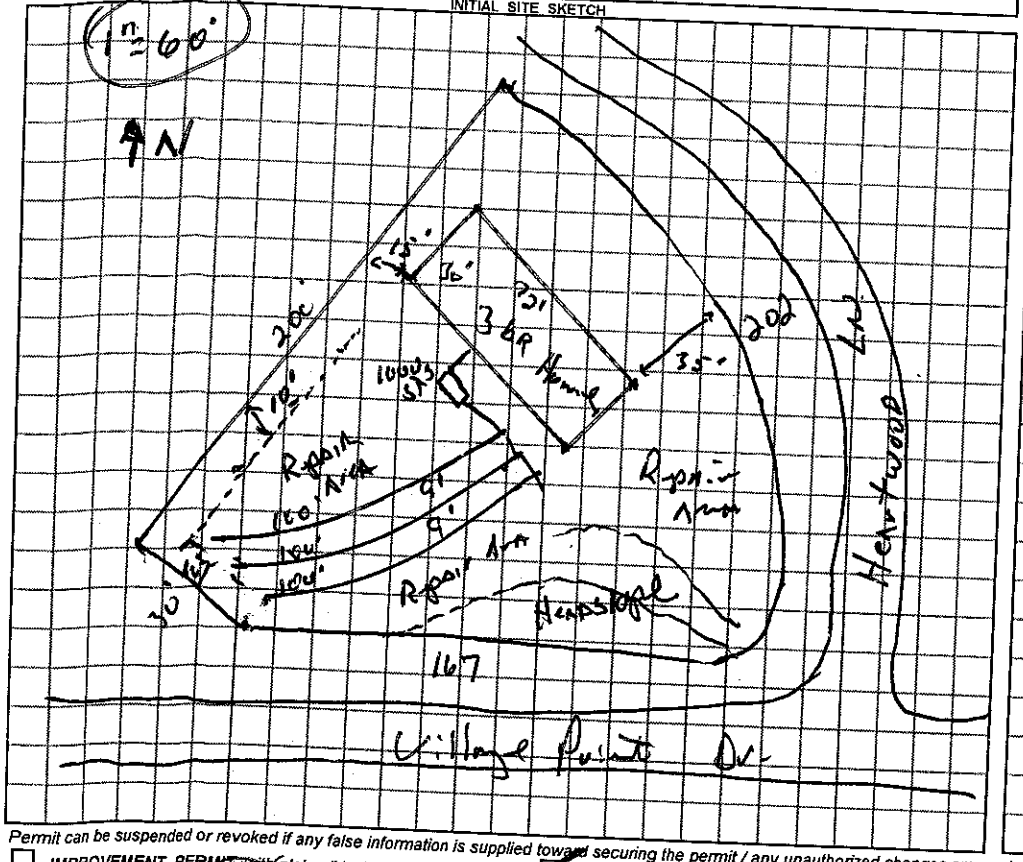

AS BUILT SKETCH

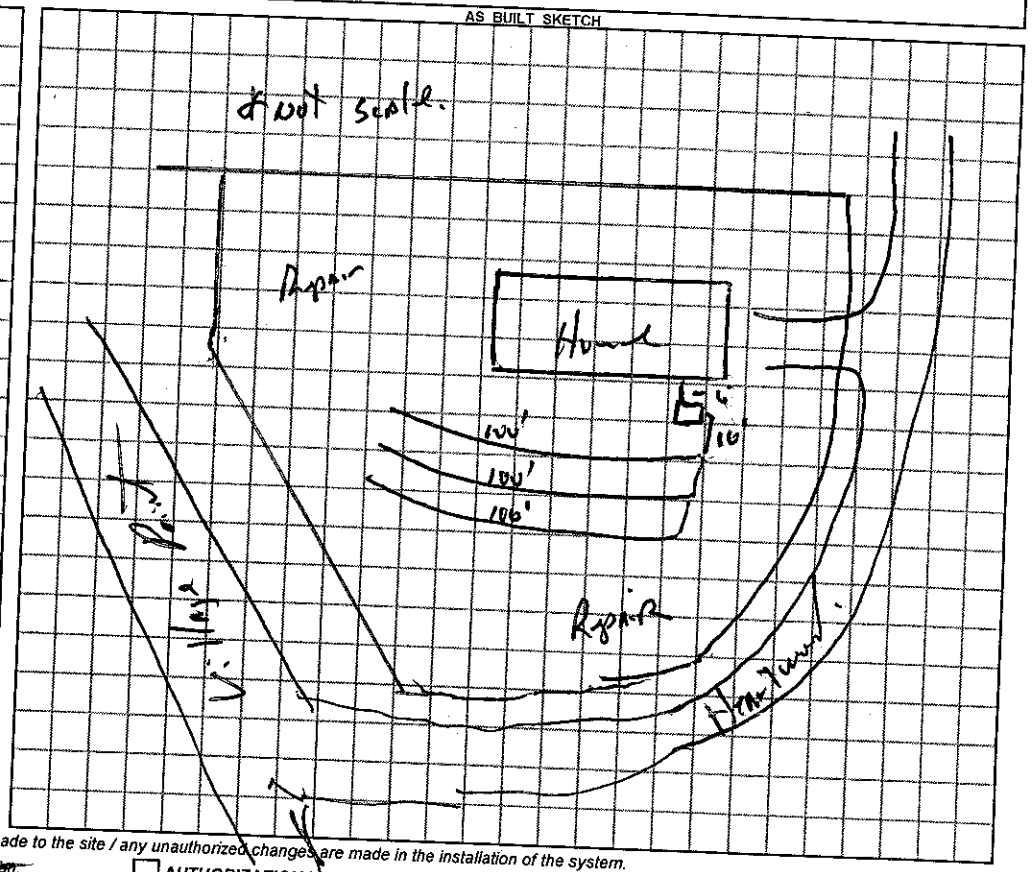

Permit can be suspended or revoked if any false information is supplied toward securing the permit / any unauthorized changes are made to the site / any unauthorized changes are made in the installation of the system.

☐ IMPROVEMENT PERMIT with plat valid without expiration ☑ IMPROVEMENT PERMIT with ~~plat valid without expiration~~ site plan valid 60 mo. ☐ AUTHORIZATION TO CONSTRUCT valid for period equal to IMPROVEMENT PERMIT--not to exceed 60 mo.

Owner / Applicant Signature: Darrell Alec Brandon Date 12/16/11 Installed by: 12-27-11

IMPROVEMENT PERMIT by: REHS Date 15 Dec. 11 OPERATION PERMIT by: Tim Abee REHS Date 8 Feb. 12

AUTHORIZATION TO CONSTRUCT by: REHS Date 12-27-11 Existing System Inspected by: REHS Date

YOU SHOULD CONTACT A LOCATOR SERVICE PRIOR TO ANY EXCAVATION

White Copy – Environmental Health YELLOW COPY (Customer)