IREDELL COUNTY HEALTH DEPARTMENT

This permit voids previously issued IP dated 1-9-01.

STATESVILLE 704-878-5305 MOORESVILLE 704-664-5281

IMPROVEMENT PERMIT / AUTHORIZATION TO CONSTRUCT / OPERATION PERMIT / EXISTING SYSTEM INSPECTION

PERMIT# ~~04-0530~~ 12821 PIN# ~~4705-98-8127~~ 4705-98-8427 DATE 4/23/03

OWNER OR CONTRACTOR Allied Partner PHONE: Business 871-1536 Home

ADDRESS 310 Treebark Rd. Statesville N.C. 28687

LOCATION Hwy 90 West @ Village Point, @ Heartwood on Right.

SUBDIVISION Village Point BLOCK / SECTION LOT 22 LOT AREA .57 Ac SITE CLASS. Ops DESIGN FLOW 480 L.T.A.R. .30 gpd/ft²

Septic Tank: 1,000 Gallons; STB 1012 Date 04/13/02

Pump Tank: Gallons; PT Date

Pump Make: Model Equiv. to 1600 Serial No.

Nitrification Field: No Fields 1 Square Feet Linear Feet 275

No Lines 7 Trench Width 2ft Max Trench Bottom Depth 36" Gravel Depth 6"

☒ New System ☐ Repair System Type: I, II, ③, IV, V, VI

System Description: Gravity, 50% Reduction

Repair System Description: Pump, Innovative

Maintenance Agreement Required: ☐ Yes ☒ No

☒ House/Mod. Home No. Bedrooms 4

☐ Mobile Home No. Bathrooms 2

☐ Business No. Employees

☐ Other

☐ Slab ☒ Crawl Space ☐ Basement w/plumbing ☐ Basement wo/plumbing


Water Supply: ☐ Individual ☒ Public ☐ Community

Comments:/Conditions: ① * Gullied Area to be cleaned out and properly back filled in order to go up to 5 ft separation with Septic laterals. ② Install (1) one flow divider tee + two (2) distribution boxes

Comments:/Conditions:

- S.T. INSTALLED USING TUFF TIGHT FILTER + MARKER.
- Lines okay

INITIAL SITE SKETCH

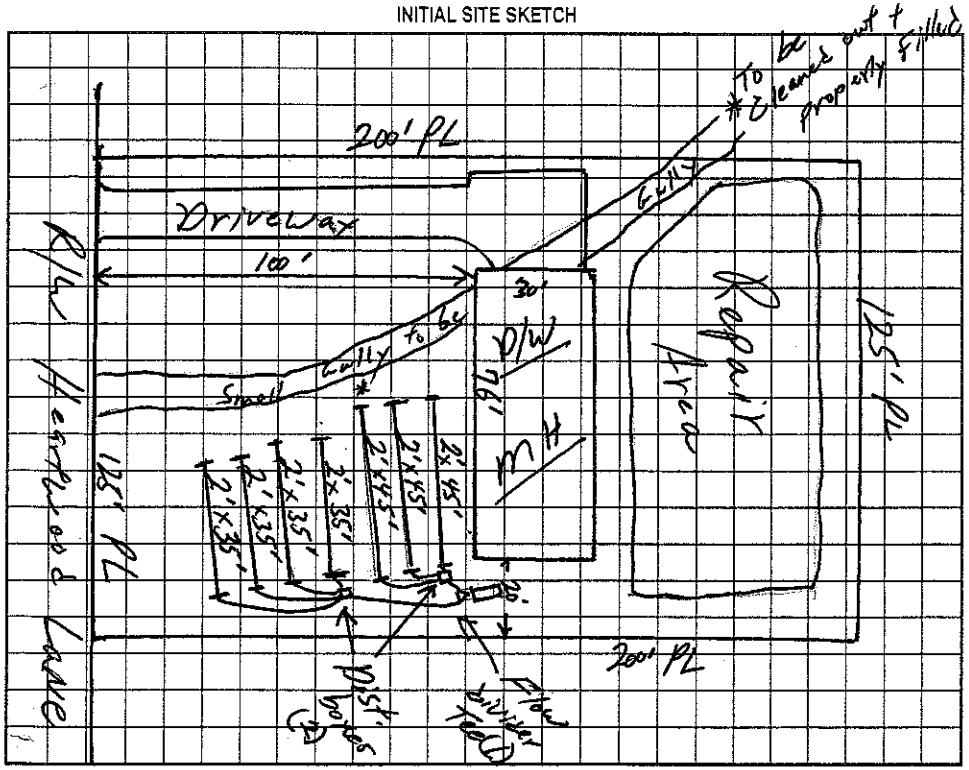

AS BUILT SKETCH

Installed As Shown per Initial Site Sketch

Permit can be suspended or revoked if any false information is supplied toward securing the permit/any unauthorized changes are made to the site/any unauthorized changes are made in the installation of the system. Improvement Permit with plat valid without expiration. Improvement Permit with site plan valid for sixty months. Authorization to Construct is valid for a period equal to that of Improvement Permit – not to exceed sixty months.

Signed: Ed Alcorn date 4-25-03 Installed by: Craig Thompson

Improvement Permit by: William O. Johnson date 4/23/03 Operation Permit by: William O. Johnson date 5/12/03

Authorization to Construct by: William O. Johnson date 4/23/03 Existing System Inspection by: date

HEALTH DEPT. COPY: WHITE OWNER COPY (FINAL): YELLOW OWNER COPY (INITIAL): PINK