IREDELL COUNTY HEALTH DEPARTMENT

STATESVILLE 704-878-5305 MOORESVILLE 704-664-5281

IMPROVEMENT PERMIT / AUTHORIZATION TO CONSTRUCT / OPERATION PERMIT / EXISTING SYSTEM INSPECTION

PERMIT# Repair PIN# DATE 4-29-99

OWNER OR CONTRACTOR Douglas Rimmes PHONE: Business Home 872-4349

ADDRESS 4179 Taylorsville Hwy Statesville

LOCATION 90W Past Loray ~~Mill~~ 3rd House on left after Griffin Heating/A.C

SUBDIVISION BLOCK / SECTION LOT LOT AREA SITE CLASS P/S DESIGN FLOW 360 L.T.A.R. Existing

Septic Tank: 1000 Ex Gallons; STB Date

Pump Tank: Gallons; PT Date

Pump Make: Model Serial No.

Nitrification Field: No Fields 1 Square Feet Linear Feet 225ft

No Lines 2 Trench Width 36in Max Trench Bottom Depth 36in Gravel Depth 12in

☐ New System ☒ Repair System Type: ☒ III, IV, V, VI

System Description:

Repair System Description: Gravity Conventional

Maintenance Agreement Required: ☐ Yes ☒ No

☐ Slab ☐ Crawl Space ☒ Basement w/plumbing ☐ Basement wo/plumbing

☒ House/Mod. Home No. Bedrooms 3

☐ Mobile Home No. Bathrooms 2

☐ Business No. Employees

☐ Other


Water Supply: ☐ Individual ☒ Public ☐ Community

Comments/Conditions: This permit serves as 'Notice of Violation' Install 2 lines on contour - Need to smooth out hump


Need to tie washer line into system.

Comments/Conditions

INITIAL SITE SKETCH

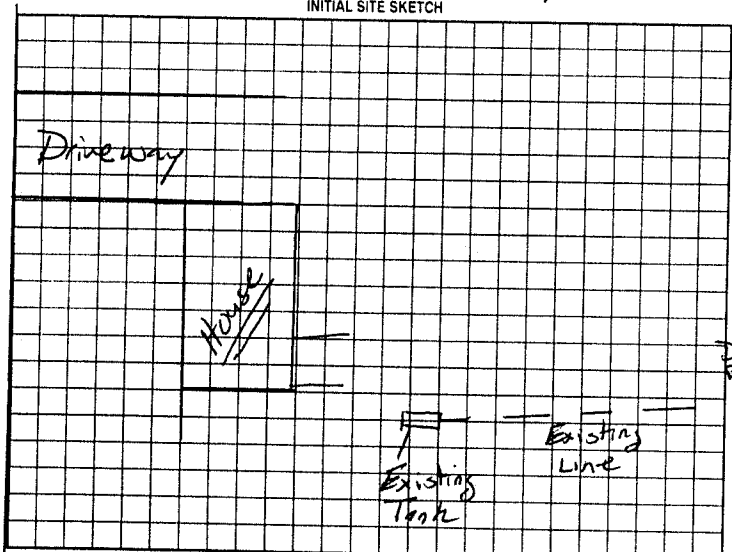

AS BUILT SKETCH

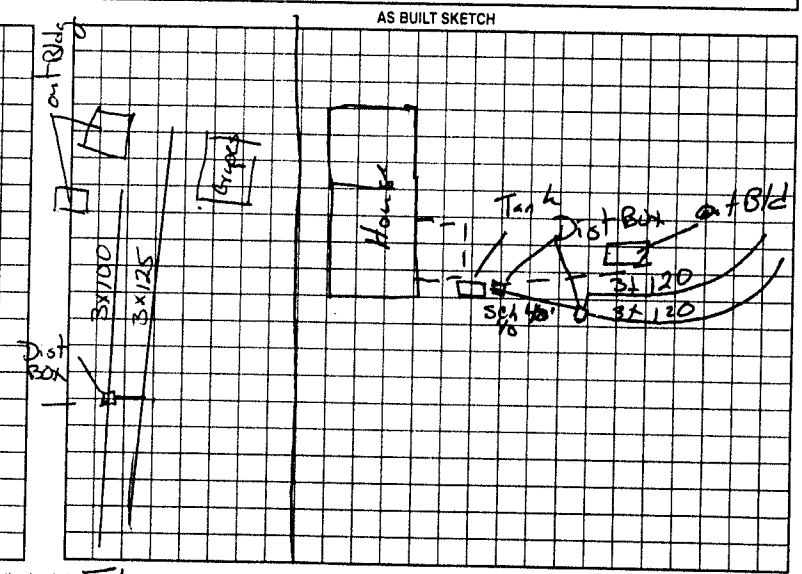

Permit can be suspended or revoked if any false information is supplied toward securing the permit/any unauthorized changes are made to the site/any unauthorized changes are made in the installation of the system. Improvement Permit with plat valid without expiration. Improvement Permit with site plan valid for sixty months. Authorization to Construct is valid for a period equal to that of Improvement Permit – not to exceed sixty months.

Signed: Douglas F Rimmes date 4/29/99

Improvement Permit by: Mark C Ost RS date 4-29-99

Authorization to Construct by: Mark C Ost RS date 4-29-99

Installed by: Wes Lytton

Operation Permit by: Mark C Ost RS date 7-20-99

Existing System Inspection by: date

HEALTH DEPT. COPY: WHITE OWNER COPY (FINAL) YELLOW OWNER COPY (INITIAL) PINK