IREDELL COUNTY HEALTH DEPARTMENT

STATESVILLE 704-878-5305 MOORESVILLE 704-664-5281

IMPROVEMENT PERMIT / CERTIFICATE OF COMPLETION / OPERATION PERMIT / EXISTING SYSTEM INSPECTION

PROPERTY DESCRIPTION NO. 23506 DATE 4-20-96 TAX MAP NO. 96-A-8A Watershed: ☐ Yes ☒ No

OWNER OR CONTRACTOR DONALD P. LACKEY, SR PHONE: Business _____ Home 585-9115

ADDRESS 225 E. LACKEY FARM RD, STONY POINT, NC 28678

LOCATION US 64 W, TL LACKEY FARM RD (1st) ~ 0.75 MILE ON RIGHT ACCESS FROM SPLIT RAIL FENCE.

SUBDIVISION _____ BLOCK / SECTION _____ LOT _____ LOT AREA AMPLE SITE CLASS PS DESIGN FLOW 360 L.T.A.R. EXISTING

Septic Tank: EXISTING Gallons; STB _____ Date _____

Pump Tank: _____ Gallons; PT _____ Date _____

Pump Make: _____ Model _____ Serial No. _____

Nitrification Field: No Fields ____ Square Feet _____ Linear Feet EXISTING

No Lines _____ Trench Width _____ Max Trench Bottom Depth _____ Gravel Depth _____

System Type: (I) II III IV V VI

System Description: CONVENTIONAL GRAVITY

Repair System Description: _____

Maintenance Agreement Required: ☐ Yes ☒ No

☐ Slab ☑ Crawl Space ☐ Basement w/plumbing ☐ Basement wo/plumbing

☐ House/Mod. Home No. Bedrooms 3

☒ Mobile Home No. Bathrooms 2

☐ Business No Employees ____

☐ Other _____

Water Supply:

☐ Individual

☐ Community

☑ Public

Comments:


Comments:

① KEEP MH MINIMUM 5' FROM SYSTEM

② SYSTEM INSTALLED APPROX. 1968 — UNDER 1200 ACCORDING TO TODAY'S STANDARDS

INITIAL SITE SKETCH

AS BUILT SKETCH

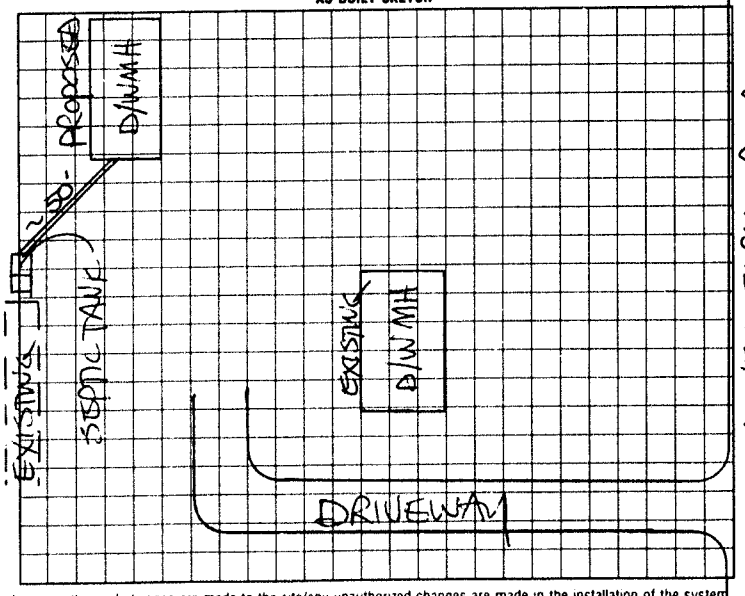

I understand that this permit can be suspended or revoked if any false information is supplied toward securing the permit/any unauthorized changes are made to the site/any unauthorized changes are made in the installation of the system

Signed: _____

Improvement Permit by: _____ date _____

Existing System Inspection by: STEVE HENDRICK date 4-20-96

Installed by _____

Certificate of Completion by _____ date _____

Operation Permit by _____ date _____

HEALTH DEPT. COPY: WHITE INSPECTION COPY (FINAL) GREEN OWNER COPY (FINAL) YELLOW INSPECTION COPY (INITIAL) PINK OWNER COPY (INITIAL) GOLD