IREDELL COUNTY HEALTH DEPARTMENT - *ENVIRONMENTAL HEALTH* ☐ STATESVILLE OFFICE 704-878-5305 ☐ MOORESVILLE OFFICE 704-664-5281

IMPROVEMENT PERMIT / AUTHORIZATION TO CONSTRUCT / OPERATION PERMIT / EXISTING SYSTEM INSPECTION

PERMIT # 167238 PIN # 4706-04-9823 DATE 15 JULY 2011

OWNER Tom - Judy Martin APPLICANT: Bob Hayden PHONE: Home/Cell # (704) 437-6250 Business #

SITE ADDRESS E. Locke Farm Rd. Stony Point NC - OWNER / APPLICANT ADDRESS

SITE DIRECTIONS Hwy 64W TL E. Locke Farm Rd. on Rt. past Cherry Blossom Rd.

SUBDIVISION Richmount Hills BLOCK / SECTION LOT # 4 LOT AREA 1.023 AC. DESIGN FLOW 360 g/d. L.T.A.R. 0.3 g/ft²/d

Septic Tank 1000 Gallons: STB 1012-1000 Date 5-9-14
Pump Tank Gallons: P T Date
Pump Make Model Serial #
No. Nitrification Fields: 1 No. Lines 3 Linear Feet 300
Trench Width 36" Max. Trench Bottom Depth 36" Gravel Depth NA


☑ New System ☐ Repair ☐ Expansion System Type I II (III) IV V VI
System Description: 25% Reduction
Repair System Description: 25% Reduction
Maintenance Agreement Required ☐ YES ☑ NO
☑ GRAVITY ☐ PRESSURE

☑ Residence No. Bedrooms 3
☐ Business No. Persons
☐ Other No. Employees
☐ Slab ☑ Crawl Space
☐ Basement w/plumbing ☐ Basement w/o plumbing


Water Supply: ☐ Private ☑ Public ☐ Community

Comments / Conditions
Requires A.S.# / Follow contour / Heaver all setbacks

INITIAL SITE SKETCH

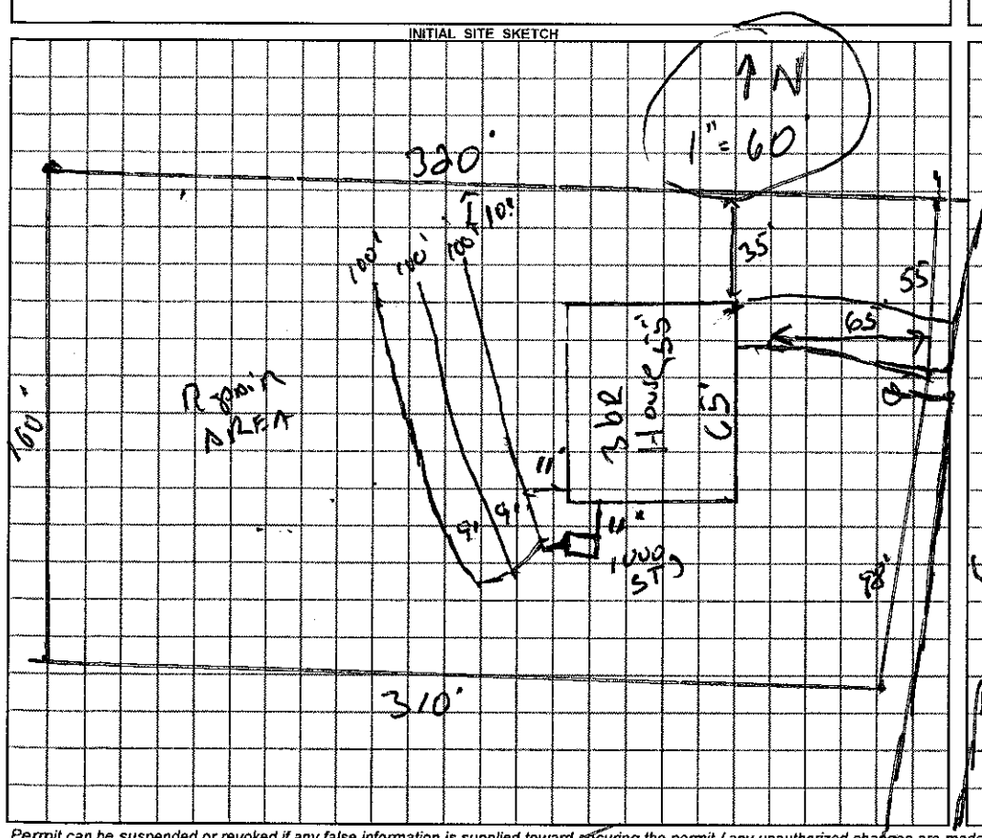

AS BUILT SKETCH

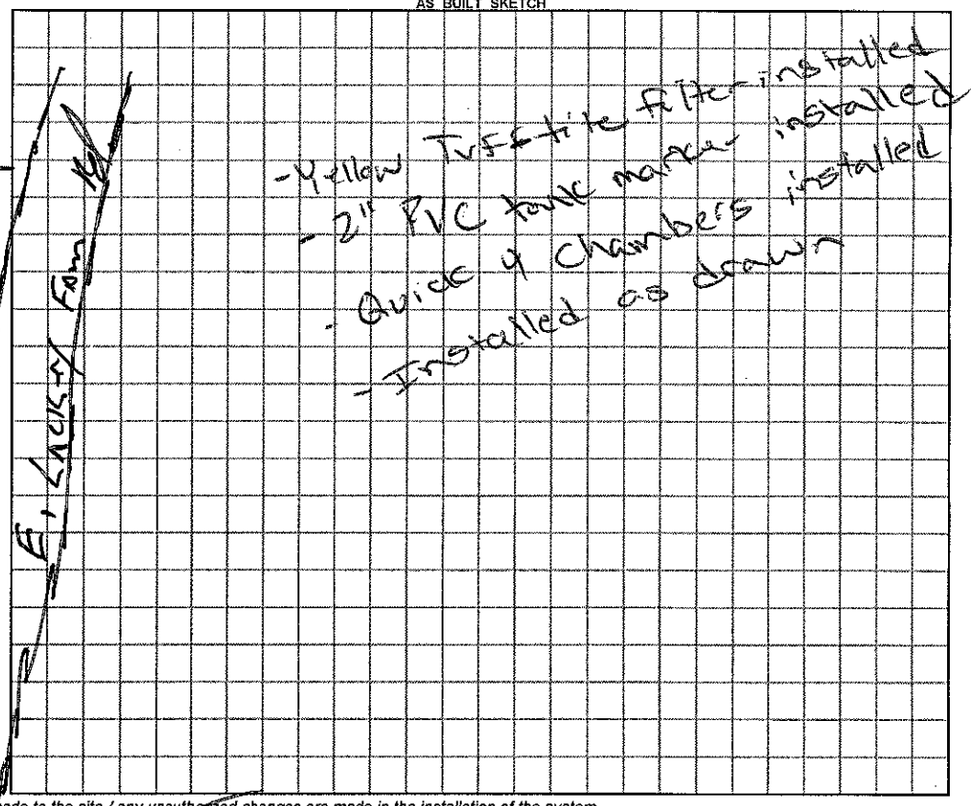

Permit can be suspended or revoked if any false information is supplied toward securing the permit / any unauthorized changes are made to the site / any unauthorized changes are made in the installation of the system.

☐ ***IMPROVEMENT PERMIT*** *with plat valid without expiration.* ☑ ***IMPROVEMENT PERMIT*** *with plat ~~valid without expiration.~~ site plan valid 60 mo.* ☑ ***AUTHORIZATION TO CONSTRUCT*** valid for period equal to IMPROVEMENT PERMIT--not to exceed 60 mo.

Owner / Applicant Signature: Bob Hayden Date 7/19/11

IMPROVEMENT PERMIT by: REHS Date 15 JULY 11

AUTHORIZATION TO CONSTRUCT by: Justin Henderson REHS Date 11-26-13

Installed by: Yountz Grading

OPERATION PERMIT by: Justin Henderson REHS Date 6-19-14

Existing System Inspected by: REHS Date

YOU SHOULD CONTACT A LOCATOR SERVICE PRIOR TO ANY EXCAVATION

White Copy – Environmental Health YELLOW COPY (Final) Owner / Applicant PINK COPY (Initial) Owner / Applicant