C1

IREDELL COUNTY HEALTH DEPARTMENT

STATESVILLE 704-878-5305 MOORESVILLE 704-664-5281

IMPROVEMENT PERMIT / AUTHORIZATION TO CONSTRUCT / OPERATION PERMIT / EXISTING SYSTEM INSPECTION

PERMIT# 132905 PIN# 4706-05-9210 DATE 3-10-06

OWNER OR APPLICANT MICKEY WALKER PHONE: Business 828-585-6471 Home 828-312-1444

ADDRESS 957 SMITH RD Stony Point NC

LOCATION 64 WEST @ LACKEY FARM RD @ SWEET CHERRY PROPERTY ON CORNER OF CHERRY BLOSSOM & SWEET CHERRY

SUBDIVISION RILLMONT HILLS BLOCK / SECTION ____ LOT 2 LOT AREA 1.99 SITE CLASS. PS DESIGN FLOW 360 L.T.A.R. .3

Septic Tank: 1000 Gallons; STB ____ Date 9-19-06

Pump Tank: ____ Gallons; PT ____ Date ____

Pump Make: ____ Model ____ Serial No. ____

Nitrification Field: No Fields 1 Square Feet 1200' Linear Feet 400'

No Lines 4X100' Trench Width 36" Max Trench Bottom Depth 36"

☒ New System ☐ Repair ☐ Expansion System Type: I (II) III IV V VI

System Description: CONV LOAD

Repair System Description: PUMP 25% REDUCTION

Maintenance Agreement Required: ☐ Yes ☒ No

Gravel Depth 10" ☒ Gravity ☐ Pressure

☒ House/Mod. Home No. Bedrooms 3

☐ Mobile Home No. Persons 6

☐ Business No. Employees ____

☐ Other ____


Water Supply: ☐ Individual ☒ Public ☐ Community

☐ Slab ☒ Crawl Space ☐ Basement w/plumbing ☐ Basement wo/plumbing


Comments/Conditions: (1) INSTALL LINES ON CONTOURS (2) EXTENSION SETBACKS (3) ANY ALLOWED SYSTEM CAN BE USED

Comments/Conditions: Installed as 3 X 100' Quick-4 - Infiltrator Filter installed / ST Marker Present /

INITIAL SITE SKETCH 1" = 50'

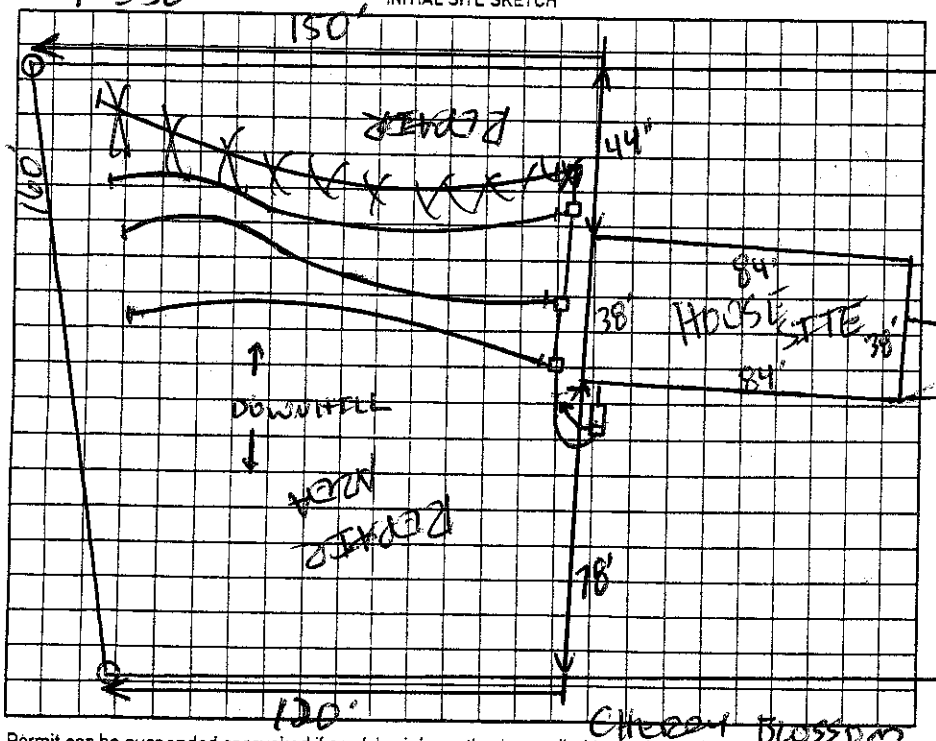

AS BUILT SKETCH

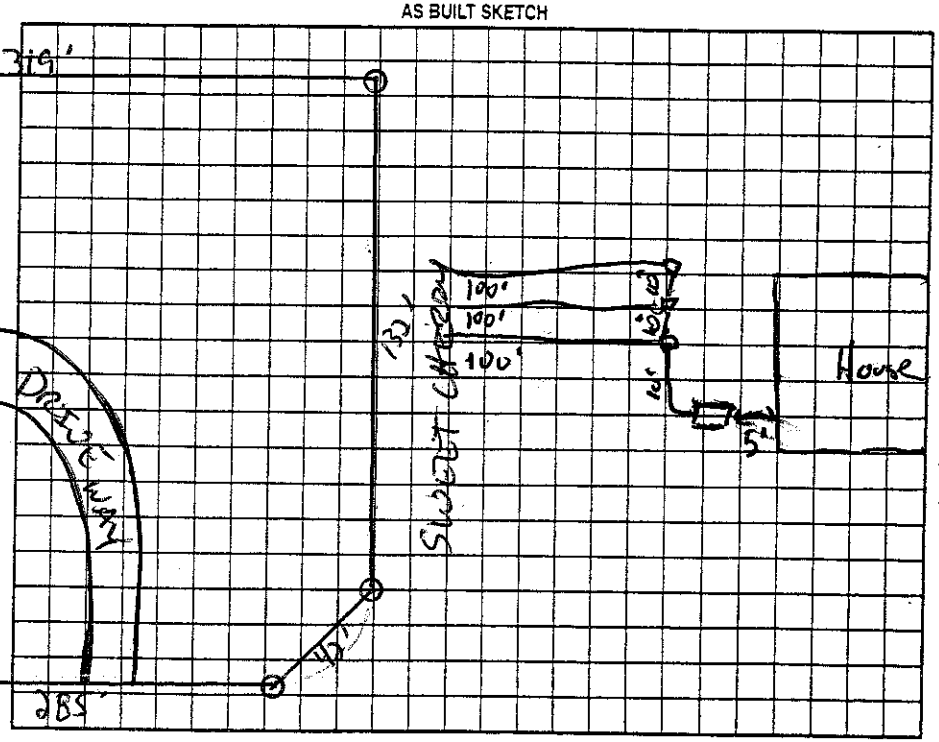

Permit can be suspended or revoked if any false information is supplied toward securing the permit/any unauthorized changes are made to the site/any unauthorized changes are made in the installation of the system. Improvement Permit with plat valid without expiration. ☐ Improvement Permit with site plan valid for sixty months ☒ Authorization to Construct is valid for a period equal to that of Improvement Permit – not to exceed sixty months.

Signed: Jay Hagan date 3-10-06

Improvement Permit by: [signature] date 3-10-06

Authorization to Construct by: [signature] date 3-10-06

Installed by: Derrick Barnes

Operation Permit by: Jay Hagan, R.S. date 25 OCT. 06

Existing System Inspection by: ____ date ____

HEALTH DEPT. COPY: WHITE OWNER COPY (FINAL): YELLOW OWNER COPY (INITIAL): PINK