IREDELL COUNTY HEALTH DEPARTMENT

STATESVILLE 704-878-5305 MOORESVILLE 704-664-5281 21

IMPROVEMENT PERMIT / AUTHORIZATION TO CONSTRUCT / OPERATION PERMIT / EXISTING SYSTEM INSPECTION

PERMIT# 123795 PIN# 4706-06-8424 DATE 9-7-04

OWNER OR CONTRACTOR Roger L. Dufre PHONE: Business — Home (704) 878-0802

ADDRESS 130 Duke Farm Lane Statesville N.C. 28625

LOCATION Hwy 90 W, @ E. Lackey Farm, on right before Hwy 64

SUBDIVISION — BLOCK / SECTION — LOT 3 LOT AREA .693 Acre SITE CLASS. PS DESIGN FLOW 360 L.T.A.R. Existing

Septic Tank: Existing Gallons; STB — Date —
Pump Tank: — Gallons; PT — Date —
Pump Make: — Model — Serial No. —
Nitrification Field: No Fields — Square Feet — Linear Feet Existing
No Lines 5 Trench Width 36" Max Trench Bottom Depth — Gravel Depth —

☒ ~~New System~~ Existing ☐ Repair System Type: ☒ I, ☐ II, ☐ III, ☐ IV, ☐ V, ☐ VI
System Description: Gravity, Conventional
Repair System Description: —
Maintenance Agreement Required: ☐ Yes ☒ No

☐ House/Mod. Home ☒ Mobile Home ☐ Business ☐ Other
No. Bedrooms 3 No. Bathrooms — No. Employees —
☐ Slab ☒ Crawl Space ☐ Basement w/plumbing ☐ Basement wo/plumbing


Water Supply: ☐ Individual ☒ Public ☐ Community

Comments/Conditions:

INITIAL SITE SKETCH (Ref: Fore Benfield Oct. 1997)

Comments/Conditions: - Existing System NOT in use at time of inspection; System appears to have been working properly. - maintain proper setbacks when placing House on lot.

AS BUILT SKETCH

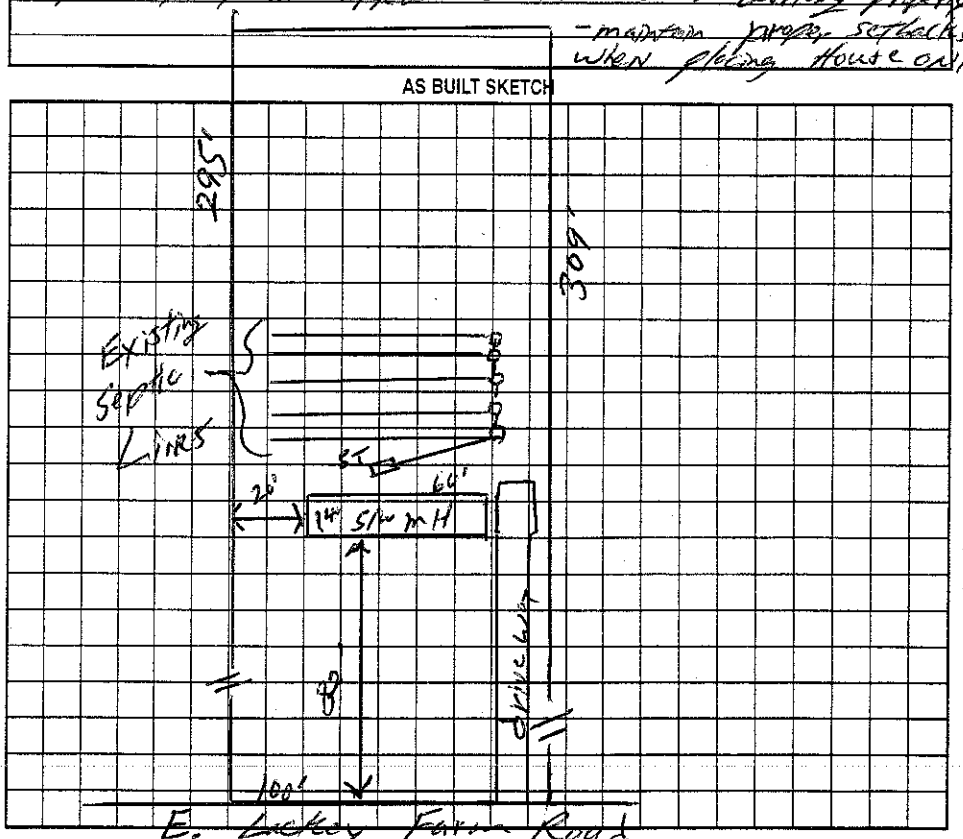

Permit can be suspended or revoked if any false information is supplied toward securing the permit/any unauthorized changes are made to the site/any unauthorized changes are made in the installation of the system. Improvement Permit with plat valid without expiration. Improvement Permit with site plan valid for sixty months. Authorization to Construct is valid for a period equal to that of Improvement Permit – not to exceed sixty months.

Signed: Danny K Dehn date 9-7-04 Installed by: —

Improvement Permit by: — date — Operation Permit by: — date —

Authorization to Construct by: — date — Existing System Inspection by: William O. Johnson date 9/7/04

HEALTH DEPT. COPY: WHITE OWNER COPY (FINAL): YELLOW OWNER COPY (INITIAL): PINK