IREDELL COUNTY HEALTH DEPARTMENT

STATESVILLE 704-878-5305 ✓ MOORESVILLE 704-664-5281

IMPROVEMENT PERMIT / AUTHORIZATION TO CONSTRUCT / OPERATION PERMIT / EXISTING SYSTEM INSPECTION

PERMIT# 104694 PIN# 4706-09-0993.2 DATE 3/1/02

OWNER OR CONTRACTOR Lorrie Payne PHONE: Business — Home (704) 585-6294

ADDRESS P.O. Box 44 Stony Point N.C. 28678

LOCATION Hwy 64 W East Leckey Farm Rd. On mailbox #425 down drive past doublewide on right.

SUBDIVISION Anna Smith Estate BLOCK / SECTION — LOT 2 LOT AREA 4.672 Acres SITE CLASS 15 DESIGN FLOW 360 L.T.A.R. .30 gpd

Septic Tank: 4,000 Gallons: STB 1012 Date 12-18-01
Pump Tank: — Gallons: PT — Date —
Pump Make: — Model — Serial No —
Nitrification Field: No Fields 1 Square Feet 1200 Linear Feet 400
No Lines 4 @ 100' Trench Width 36" Max Trench Bottom Depth 30" Gravel Depth 12"

X New System ☐ Repair System Type: I (II) III IV V VI
System Description: Growth Conv.
Repair System Description: Gravity, Conventional
Maintenance Agreement Required: ☐ Yes X No

☐ House/Mod. Home No. Bedrooms 3
X Mobile Home No. Bathrooms 2
☐ Business No. Employees —
☐ Other —
☐ Slab X Crawl Space ☐ Basement w/plumbing ☐ Basement wo/plumbing

Water Supply: ☐ Individual X Public ☐ Community


Comments/Conditions: (1) Install lines on contour (2) Maintain proper setbacks

Comments/Conditions: Poly lok filter, ST marker Installed


503' PL

drive

(Not to Scale) INITIAL SITE SKETCH

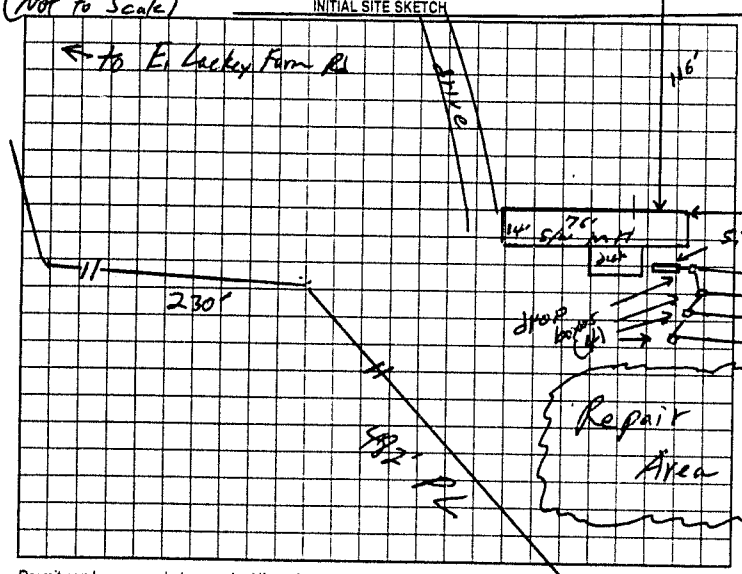

AS-BUILT SKETCH

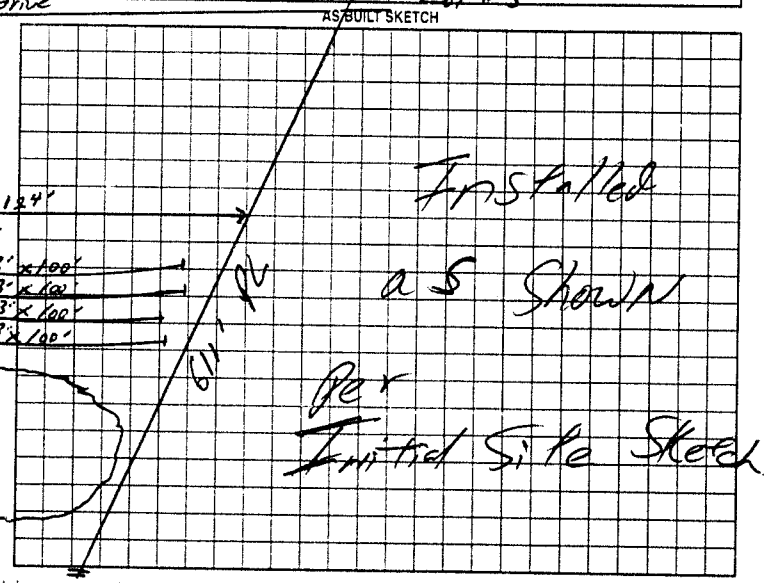

Permit can be suspended or revoked if any false information is supplied toward securing the permit/any unauthorized changes are made to the site/any unauthorized changes are made in the installation of the system. Improvement Permit with plat valid without expiration. Improvement Permit with site plan valid for sixty months. Authorization to Construct is valid for a period equal to that of Improvement Permit – not to exceed sixty months.

Signed: Lorrie Payne date 3-28-02 Installed by: Tommy Cothern

Improvement Permit by: William O. Johnson date 3/4/02 Operation Permit by: William O. Johnson date 4/30/02

Authorization to Construct by: William O. Johnson date 3/1/02 Existing System Inspection by: — date —

HEALTH DEPT COPY WHITE OWNER COPY (FINAL) YELLOW OWNER COPY (INITIAL) PINK