IREDELL COUNTY HEALTH DEPARTMENT

STATESVILLE 704-878-5305 MOORESVILLE 704-664-5281

IMPROVEMENT PERMIT / AUTHORIZATION TO CONSTRUCT / OPERATION PERMIT / EXISTING SYSTEM INSPECTION

PERMIT# 147039 PIN# 4706-07-4272 DATE 14 JANUARY 08

OWNER OR APPLICANT Ronnie & Renee Godfrey PHONE: Business Home 704-585-2385

ADDRESS P.O. Box 125 Scotts, NC 28679

LOCATION 391 E. Lackey Farm Rd. Stony Point, N.C.

SUBDIVISION BLOCK / SECTION LOT LOT AREA 0.927Ac. SITE CLASS. BS DESIGN FLOW 240 g/d L.T.A.R. 0.3, 1d/FT²

Septic Tank: 1000g Gallons; STB WP STB 1007 Date 2-12-08

Pump Tank: Gallons; PT Date

Pump Make: Model Serial No

Nitrification Field: No Fields 1 Square Feet = 800 Linear Feet 200

No Lines 5 Trench Width 36" Max Trench Bottom Depth 36"

☑ New System ☐ Repair ☐ Expansion System Type: I II (III) IV V VI

System Description: 25% Reduction

Repair System Description: 25% Reduction

Maintenance Agreement Required: ☐ Yes ☑ No

☐ House/Mod. Home No. Bedrooms 3

☑ Mobile Home No. Persons

☐ Business No. Employees

☐ Other

Water Supply: ☐ Individual ☑ Public ☐ Community

☑ Gravity ☐ Pressure ☐ Slab ☑ Crawl Space ☐ Basement w/plumbing ☐ Basement wo/plumbing

Comments:/Conditions: Follow contours / Honor all setbacks.

Comments:/Conditions: Tuff-tite F. Hm.

INITIAL SITE SKETCH

Please see Attached Layout Plan.

AS BUILT SKETCH

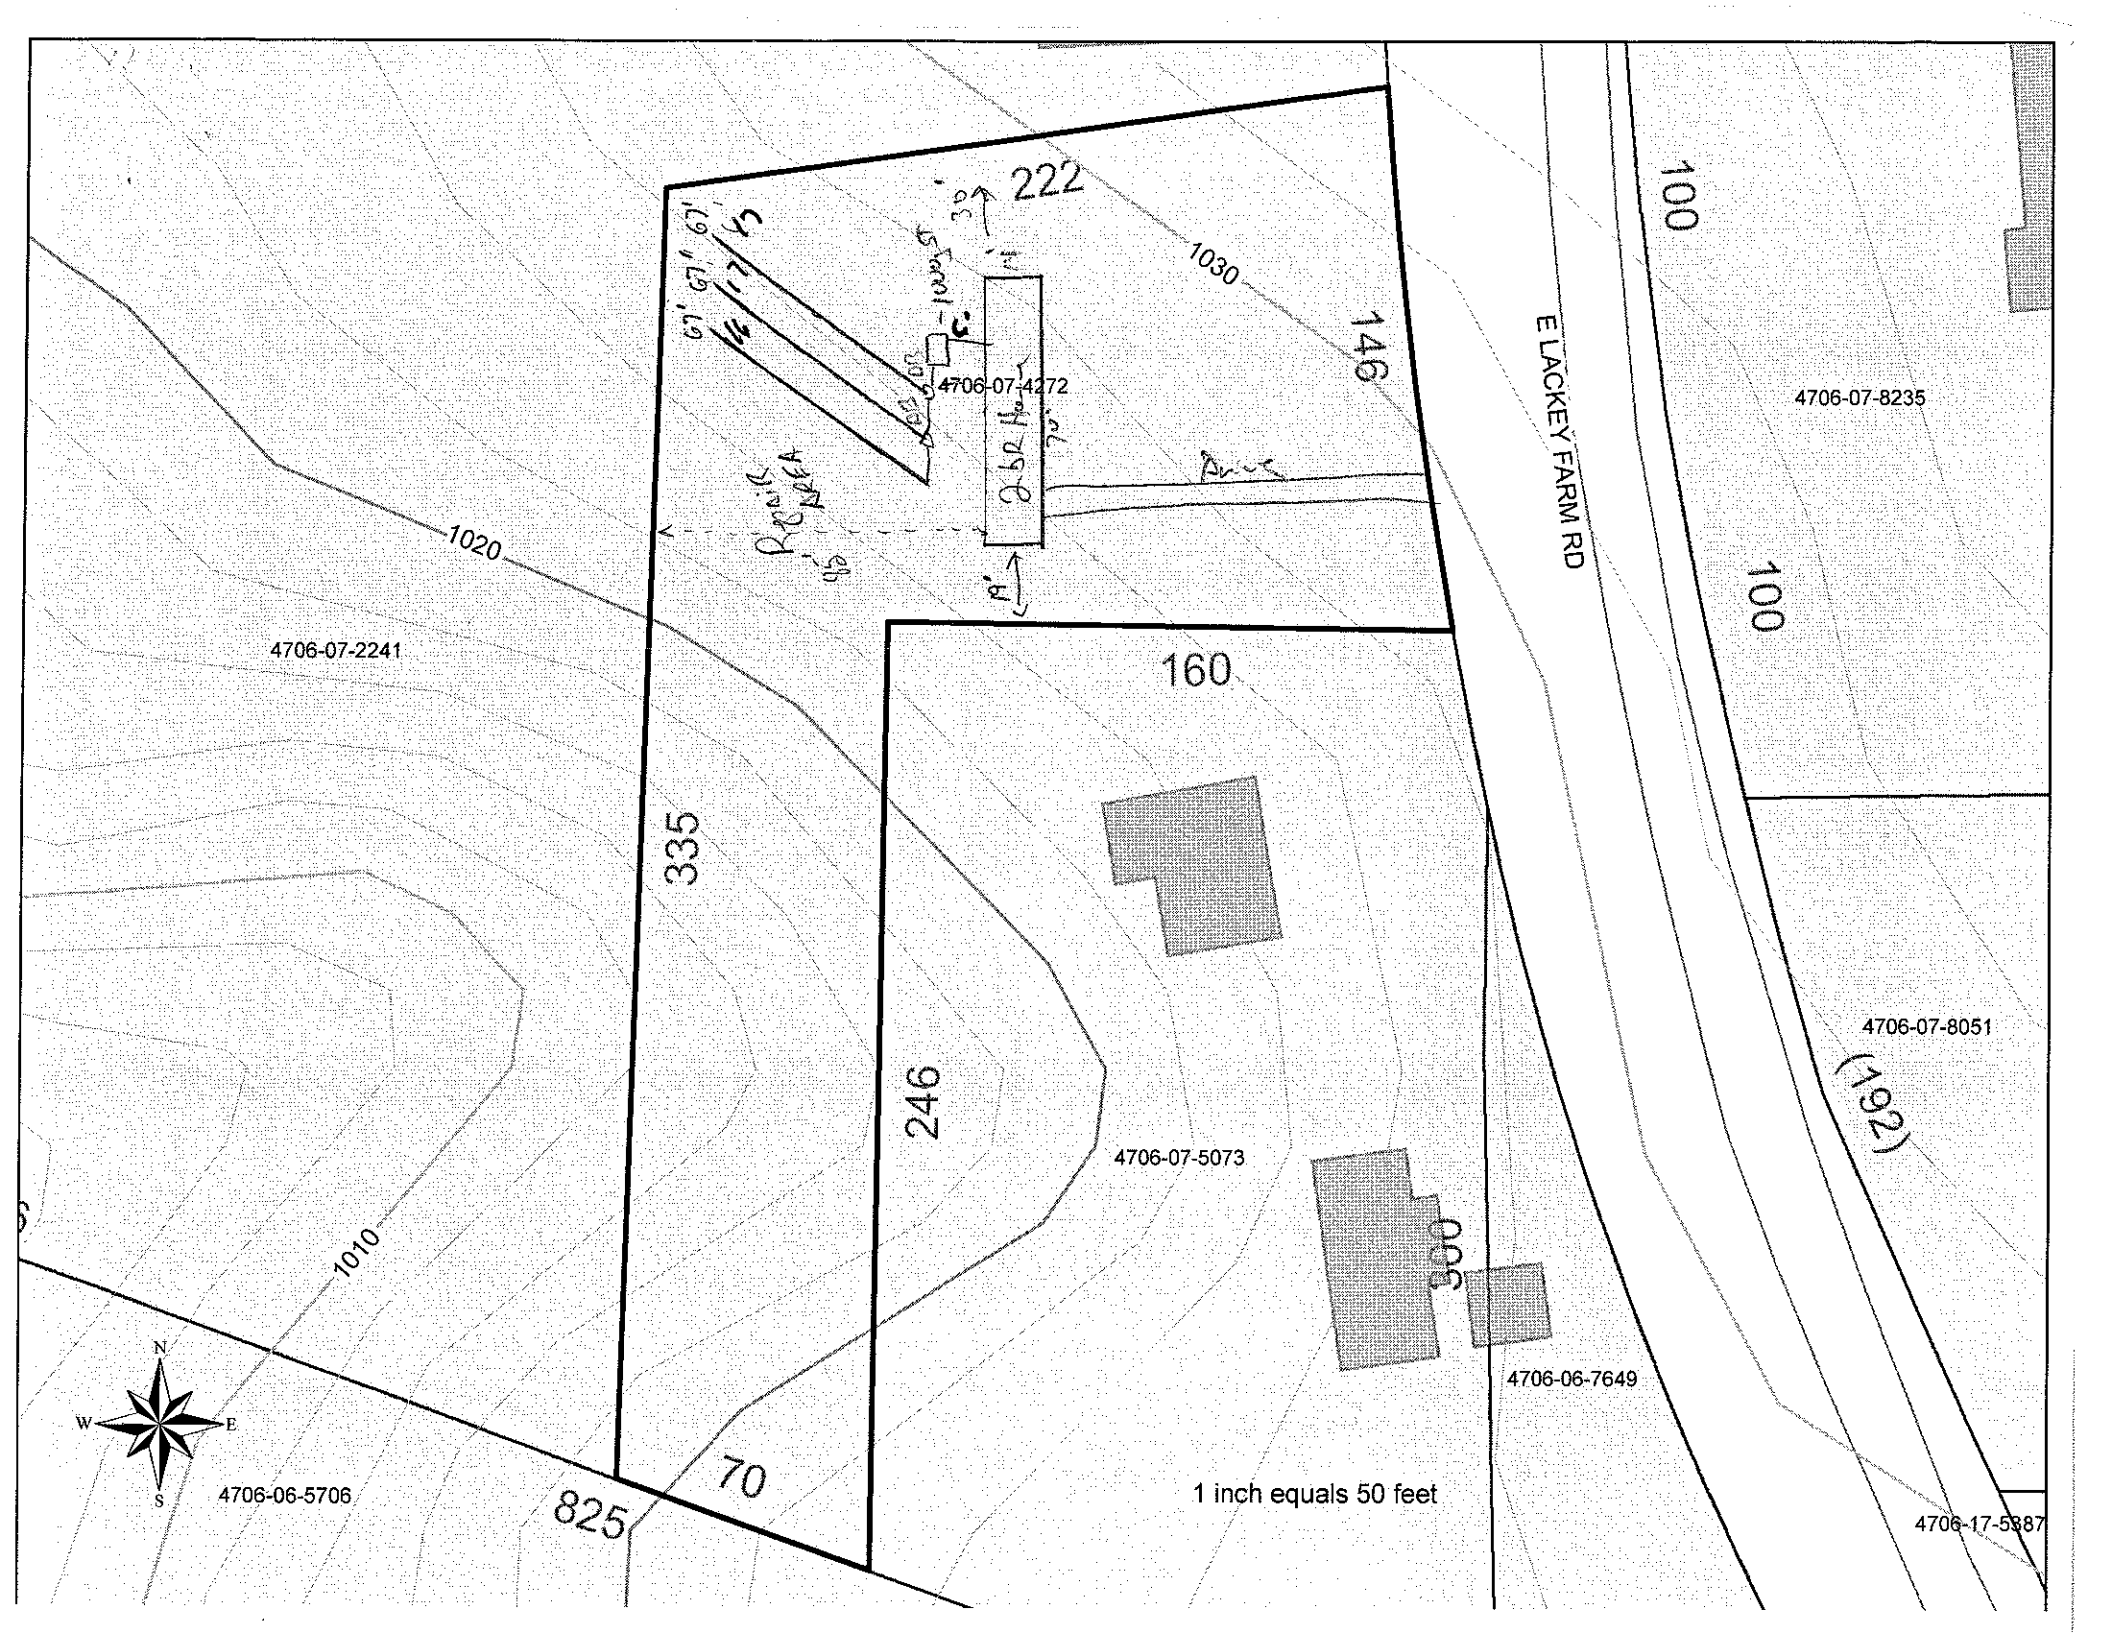
Permit can be suspended or revoked if any false information is supplied toward securing the permit/any unauthorized changes are made to the site/any unauthorized changes are made in the installation of the system. Improvement Permit with plat valid without expiration ☑ Improvement Permit with site plan valid for sixty months ☑ Authorization to Construct is valid for a period equal to that of Improvement Permit – not to exceed sixty months.

Signed: Ronnie Godfrey date 1-15-08 installed by: Alexander Precast

Improvement Permit by: , R.S. date 14 JAN 08 Operation Permit by: , R.S. date 2 April 08

Authorization to Construct by: , R.S. date 14 JAN 08 Existing System Inspection by: date

HEALTH DEPT. COPY: WHITE OWNER COPY (FINAL): YELLOW OWNER COPY (INITIAL): PINK


222
1030
146
100
100
E LACKEY FARM RD
4706-07-8235
4706-07-4272
1020
4706-07-2241
160
335
246
4706-07-5073
4706-07-8051
(192)
300
4706-06-7649
1010
70
825
4706-06-5706
4706-17-5387
1 inch equals 50 feet
N
W
E
S