14229.

42647

IREDELL COUNTY HEALTH DEPARTMENT

IMPROVEMENT PERMIT AND CERTIFICATE OF COMPLETION / OPERATIONS PERMIT

OWNER OR CONTRACTOR C. HERMAN HILL DATE 5-20-92. PERMIT NO. 9J-1-A-25.

PHONE: Business ______ Home ______

LOCATION Hwy 90W-TL on Lackey Farm Rd. (just past Scotts School) go ½ mi. on left.

SUBDIVISION NAME ______

LOT NO. ______ SECTION OR BLOCK NO. ______ S.R. No. ______

House ☑ Mobile Home ☐ Business ☐ Other ______

No. Bedrooms 3 No. Bathrooms 1

Garbage Disposal Unit Yes ☐ No ☑

Auto. Dishwasher Yes ☐ No ☑

Auto. Wash. Machine Yes ☑ No ☐

Lot Area Ample.

Soil Characteristics Prov. Suitable.


Application Rate .4gpd/sq.ft.

Topography 2-8%

Depth to Water Table 10'+

Rock or other impervious formations none observed.

______ Basement with Plumbing ______ Basement without Plumbing ✓ No Basement ______ Crawl Space

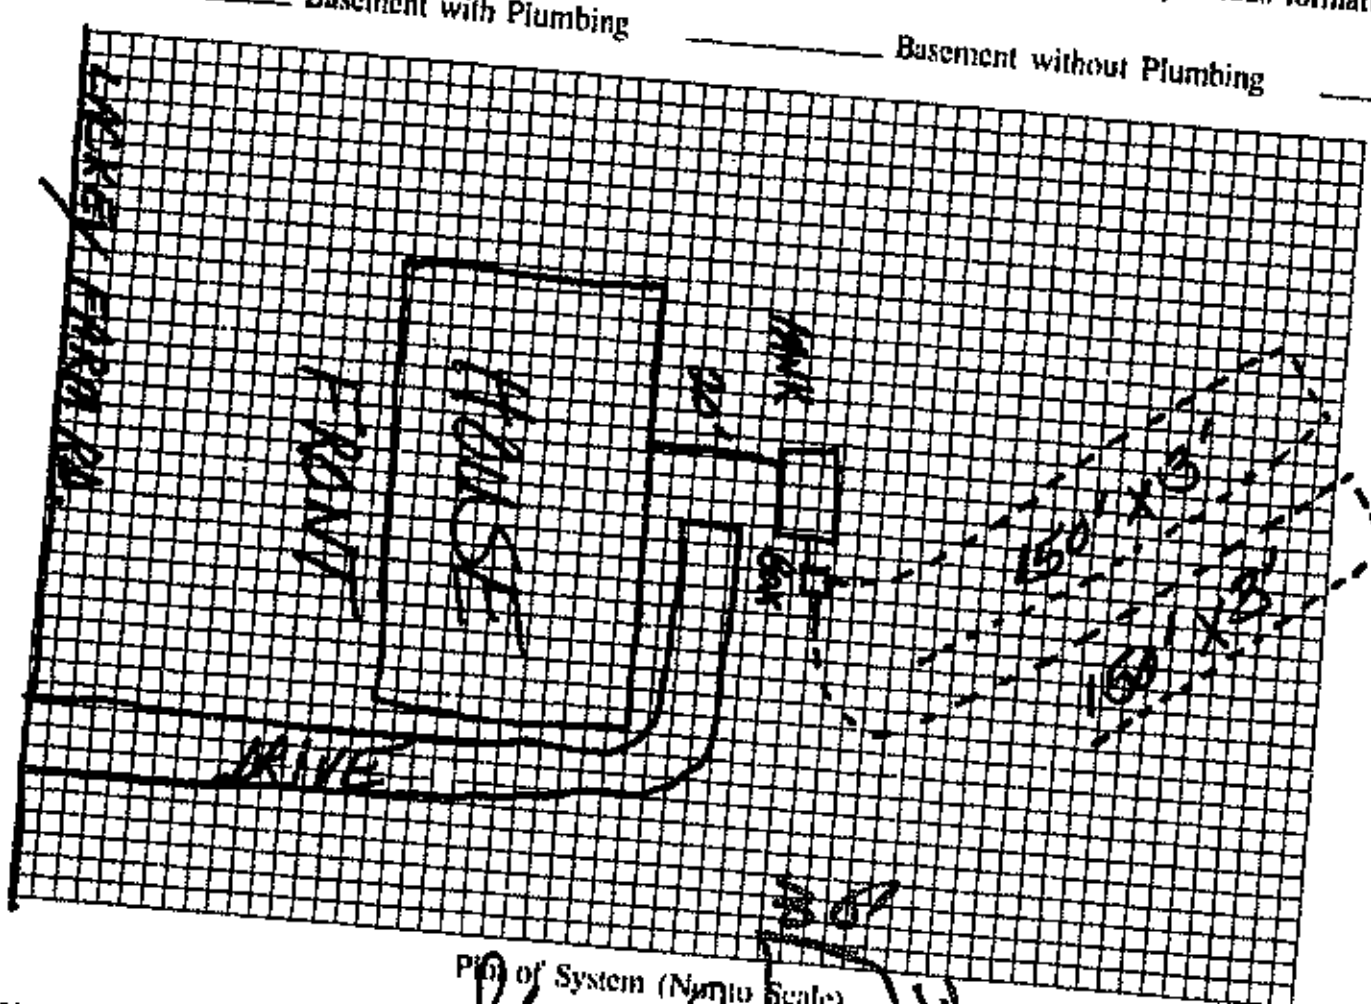

Plan of System (Not to Scale)

Size of Tank 1000 Gals.

Nitrification Field: 2

No. of Lines

Sq. Ft. 900 Linear Ft. 300

Depth of Stone in Lines 12"

Water Supply: Individual ☐ Public ☑

Installed by Jones Huddle

I understand and agree to install a septic tank system as specified on this Improvement Permit.

Signed: ______

(IMPROVEMENT PERMIT IS VALID FOR 60 MONTHS FROM DATE OF ISSUE.)

IMPROVEMENT PERMIT BY Steve Brown

COMMENTS ______

CERTIFICATE OF COMPLETION BY Steve Brown DATE 5-20-92.

EXISTING SYSTEM CHECKED BY ______ DATE ______

CONSTRUCTION MUST COMPLY WITH ALL OTHER APPLICABLE STATE AND LOCAL REGULATIONS

Permit is VOID if any unauthorized changes are made in installation of system, and/or if any unapproved changes are made to the site, and/or if any false information is supplied toward securing Improvement Permit.

Health Dept. Copy: White Inspection Dept. Copy: Yellow Sanitarian's Copy: Pink Owner's Copy: Gold

Location of the proposed 30 x 30 Detached Garage **addition does not appear to impact the existing on-site septic system.**NOTE:** Keep 5' from septic system

[signature] **REHS**

Date: 12 October 2011

ICHD-Environmental Health Division