IREDELL COUNTY HEALTH DEPARTMENT

STATESVILLE 704-878-5305 MOORESVILLE 704-664-5281

IMPROVEMENT PERMIT / AUTHORIZATION TO CONSTRUCT / OPERATION PERMIT / EXISTING SYSTEM INSPECTION

PERMIT # 16161 PIN # 4706078415 DATE 6-9-10

OWNER or APPLICANT William Larry Feimster PHONE: Business 704-585-2280 Home:

OWNER or APPLICANT ADDRESS 400 E. Lackey Farm Rd.

LOCATION / DIRECTIONS 64/90; (R) on E. Lackey, 6th driveway on right

SUBDIVISION n/a BLOCK / SECTION LOT # 21 LOT AREA .658 DESIGN FLOW 240 L.T.A.R. Ex

Septic Tank Ex Gallons: STB Date

Pump Tank Gallons: P T Date

Pump Make Model Serial #

Nitrification Field No Fields Ex No Lines Ex Linear Feet Ex

Trench Width Ex Max. Trench Bottom Depth Ex Gravel Depth Ex ☒ GRAVITY ☐ PRESSURE

☐ New System ☐ Repair ☐ Expansion System Type I II III IV V VI

System Description:

Repair System Description:

Maintenance Agreement Required ☐ YES ☒ NO

☒ Residence No. Bedrooms 2

☐ Business No. Persons

☐ Other No. Employees

☐ Slab ☒ Crawl Space


☐ Basement w/plumbing ☐ Basement w/o plumbing

Water Supply: ☐ Private ☒ Public ☐ Community


Comments / Conditions

Comments / Conditions

INITIAL SITE SKETCH

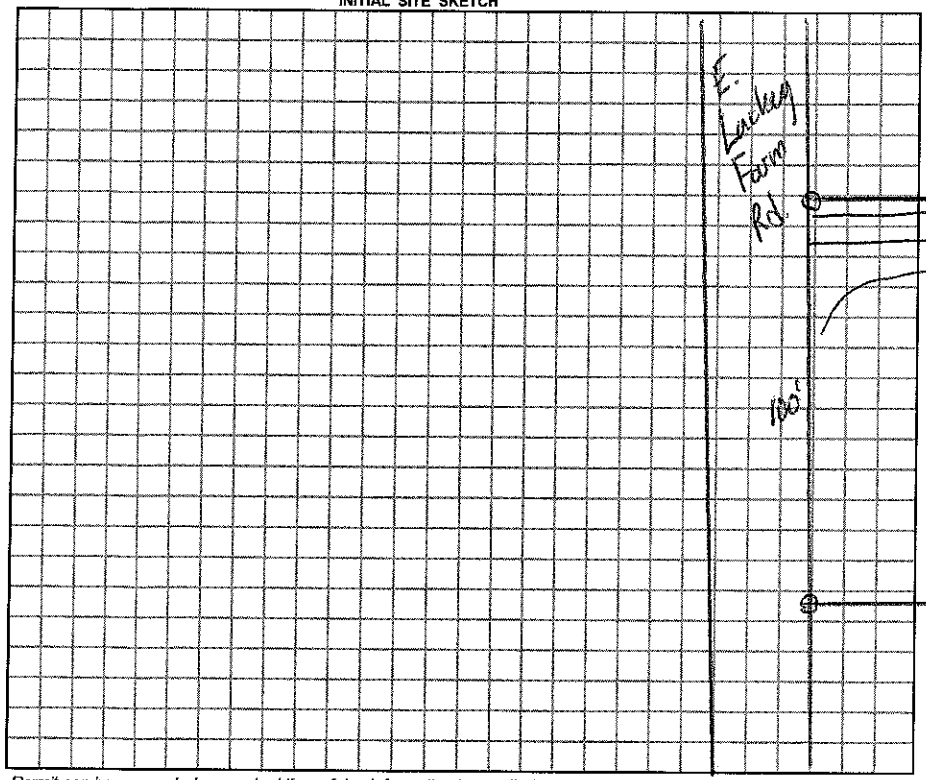

AS BUILT SKETCH

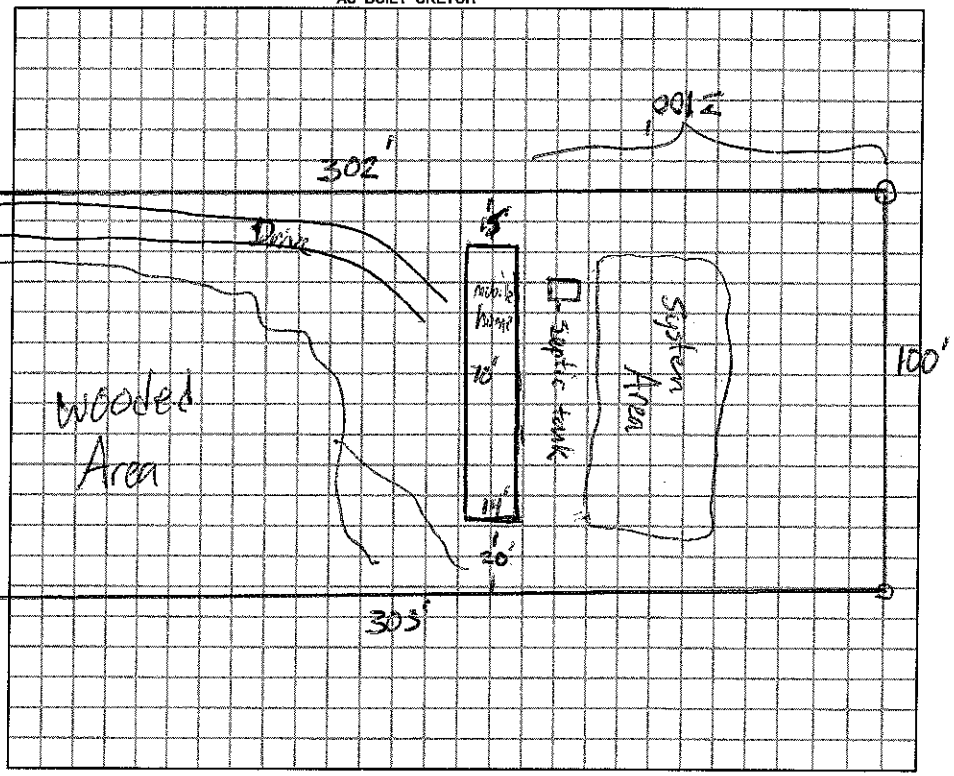

Permit can be suspended or revoked if any false information is supplied toward securing the permit / any unauthorized changes are made to the site / any unauthorized changes are made in the installation of the system.

☐ *IMPROVEMENT PERMIT w / plat valid without expiration.* ☐ *IMPROVEMENT PERMIT w / site plan valid for 60 mos.* ☒ *AUTHORIZATION TO CONSTRUCT valid for period equal to IMPROVEMENT PERMIT-not to exceed 60 mo.*

Owner / Applicant Signature: Larry Feimster Date 7-1-10

Improvement Permit by: Date

Authorization to Construct by: Date

YOU SHOULD CONTACT A LOCATOR SERVICE PRIOR TO ANY EXCAVATION.

Installed by:

Operation Permit by: Date:

Existing System Inspected by: Date: 6-9-10

WHITE COPY Environmental Health YELLOW COPY (Final) Owner / Applicant PINK COPY (Initial) Owner / Applicant