ICHD - ENVIRONMENTAL HEALTH DIVISION

Statesville Office (704) 878-5305 x3456 Mooresville Office (704) 660-3625

PERMIT: AP -324048

SEPTIC: IMPROVEMENT PERMIT / AUTHORIZATION TO CONSTRUCT / OPERATION PERMIT / EXISTING SYSTEM

PIN # 4706-07-8922

APPLICANT/OWNER: WILLIAM L. FEIMSTER APPLICANT ADDRESS: 422 EAST LACKEY FARM ROAD, STONY POINT, N.C. 28678

SITE ADDRESS: 422 EAST LACKEY FARM ROAD, STONY POINT, N.C. 28678 PHONE: 704-585-2280 ALT. PHONE —

SITE DIRECTIONS: (W) ON 64, (R) ON EAST LACKEY FARM, LOT ON (R) SAP CONTROLLED: ☐ YES ☐ NO EXT


SUBDIVISION: G.F. BARNES PROPERTY SECTION: — LOT # 16+PT17 LOT AREA: 0.925 AC DESIGN FLOW: EXT L.T.A.R.: EXT

Septic Tank	1000	(gal)	STB	10 ft	Date	10-30-2021	☐ New System	☑ Repair	☐ Expansion	System Type: I	II III IV V VI
Pump Tank	—	(gal)	PT	—	Date	—	System Description:	EXISTING - CONVENTIONAL			
Pump Make	—	Model	—	Serial #	—		Repair System Description:	TANK REPLACEMENT			
# Nitrification Fields	EXT	# Lines	EXT	Linear Ft	EXT		Maintenance Agreement Required:	☐ YES	☑ NO		
Trench Width	EXT	Trench Bottom Depth(Low side)	EXT	Gravel Depth	EXT		☑ GRAVITY	☐ PRESSURE			


☑ Residence	No. Bedrooms	EXT	Water Supply		
☐ Business	No. Persons	EXT	☐ Private		
☐ Other	No. Employees	—	☑ Public		
☐ Slab	☑ Crawl Space		☐ Community		
☐ Basement w/plumbing			☐ Basement w/o plumbing		

Comments / Conditions: PUMP, CRUSH, AND FILL EXISTING TANK, INSPECT AND REPLACE D-BOX AS NEEDED, SYSTEM APPEARS TO BE FUNCTIONING

INITIAL SITE SKETCH

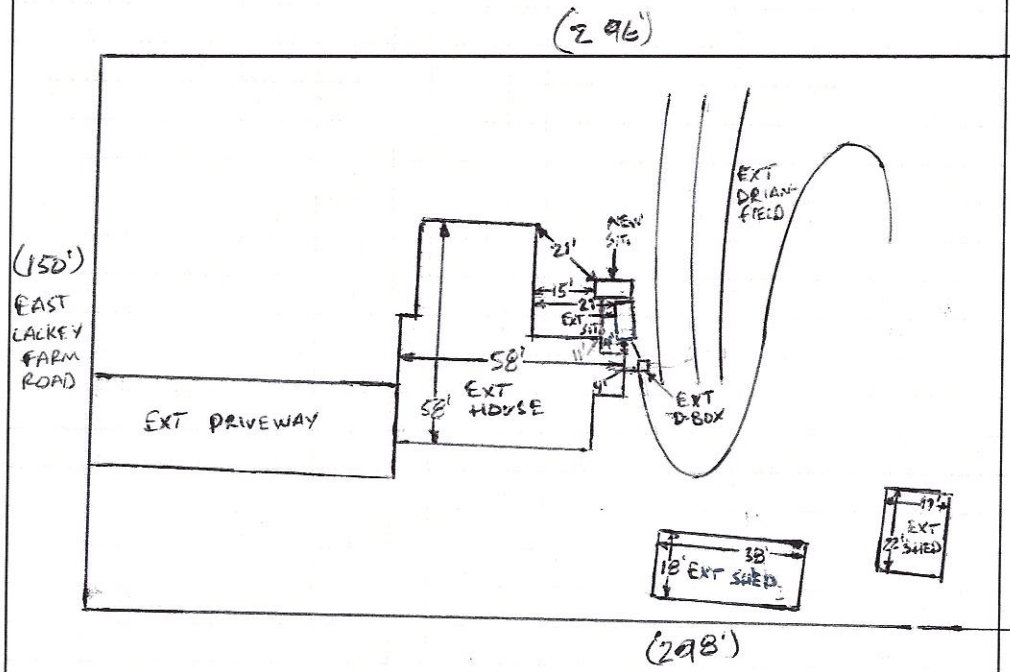

AS BUILT SKETCH

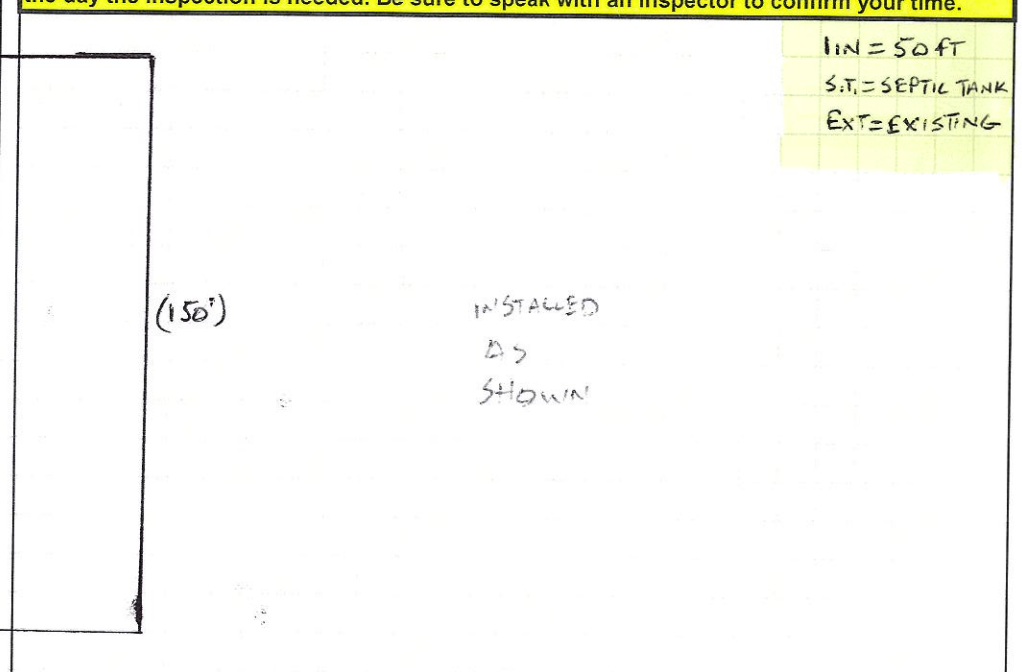

FOR SEPTIC FINAL INSPECTION CALL: 704-664-3703 between 8am-9am
the day the inspection is needed. Be sure to speak with an inspector to confirm your time.

1 IN = 50 FT
S.T. = SEPTIC TANK
EXT = EXISTING

Permit can be suspended or revoked if any false information is supplied toward securing the permit / any unauthorized changes are made to the site / any unauthorized changes are made in the installation of the system. **CONTACT A LOCATOR SERVICE PRIOR TO ANY EXCAVATION**

☐ **IMPROVEMENT PERMIT** *with plat valid without expiration.* ☑ **IMPROVEMENT PERMIT** *with site plan valid for 60 mos.* ☑ **AUTHORIZATION TO CONSTRUCT** *valid for period equal to IMPROVEMENT PERMIT--not to exceed 60 mo.*

Owner / Applicant Signature: William Larry Feimster Date: 12-29-21 Installed by: K & M GRADING

IMPROVEMENT PERMIT by: Bryant C. Winter Date: 12-28-2021 OPERATION PERMIT by: Bryant C. Winter Date: 1-11-2022

AUTHORIZATION TO CONSTRUCT by: Bryant C. Winter Date: 12-28-2021 Existing System Inspected by: Date:

FOR SEPTIC FINAL INSPECTION: CALL 704-664-3703 between 8am-9am the day the inspection is needed.

RECEIVED DEC 17 2021

APPLICATION MUST BE FILLED OUT COMPLETELY & BE LEGIBLE OR IT WILL NOT BE PROCESSED

Iredell County Health Department – Environmental Health Division

PAGE 1: *APPLICATION FORM* AP-324048

Application For: ( ) New Well Permit ( ) Well Repair Permit ( ) Well Abandonment
( ) Septic Improvement Permit ( ) Authorization to Construct ( ) Existing System Inspection (X) Septic System Repair
(No floorplan submitted with App.) (Floorplan submitted with App.)

THE ABOVE PERMIT DOCUMENTS WILL BECOME INVALID IF INFORMATION PROVIDED ON THIS APPLICATION IS FALSIFIED OR CHANGED, OR IF THE SITE IS ALTERED. THE IMPROVEMENT PERMIT IS VALID FOR EITHER 60 MONTHS OR WITHOUT EXPIRATION DEPENDING UPON DOCUMENTATION SUBMITTED. APPLICATION WITH SITE PLAN 60 MONTHS, APPLICATION WITH COMPLETE, SCALED PLAT WITHOUT EXPIRATION. SEE 15A NCAC 18A .1937(f) FOR DETAILS.

****

Page 2: *Site Plan Worksheet* form MUST accompany this application

The following optional attachments may also be submitted: ( ) Survey Plat, scaled no more than 1 inch = 60 feet
Place an (X) beside whichever is submitted if applicable ( ) Custom Site Plan, scaled no more than 1 inch = 60 feet

****

Applicant Information: (PRINT CLEARLY)

Applicant Name: Wm Larry Feimster Address: 422 East Lackey Ferry RD Zip: 28678

Applicant Email: _____ Phone: 704-585-2280 Alt. Phone: _____

Owner Name: Wm Larry Feimster Address: SAME Zip: _____

Owner Email: _____ Phone: _____ Alt. Phone: _____

****

Property Information:

Street Address: 422 East Lackey Ferry RD. Stony Point N.C. 28678

Subdivision Name: _____ Section/Phase: _____ Lot Number: _____

Driving Directions: 64-90 Lackey Ferry RD. 16 Driveway on Right Brick, white shutters Gray Roof. Carport.

****

Site Development Information: *(check or complete ALL that apply*

CHECK FOUNDATION TYPE

( ) New Single Family Residence Maximum Number of Bedrooms: 3 ( ) Crawl Space Foundation
( ) New Multi-Family Residence Maximum Number of Occupants: 2 ( ) Concrete Slab Foundation
( ) Accessory Building ( ) Swimming Pool ( ) Basement with Plumbing
( ) Bedroom(s) Addition ( ) Other Addition/Structure: _____ ( ) Basement without Plumbing
( ) Repair to failing septic system √ Tank ___ Drain lines Describe Problem: Hole top of tank

Non-Residential Site Development: Type of Business: _____
Square Footage of Building: _____ Max. Number of Employees: _____ Max. Number of Seats/Beds/Other: _____

****

Water Supply: ( ) Replacement Well – Reason: _____
( ) Multi-connection Well Number of Houses: _____ Number of Persons: _____

( ) New Well ( ) Existing Well ( ) Community Well ( ) City Water ( ) Other Public Water

****

Desired Septic System Type: *(you may rank in order of preference)* Year existing system installed: _____
( ) No Preference ( ) Alternative ( ) Conventional ( ) Innovative ( ) Modified Conventional ( ) Other: _____

****

Please answer the following to the best of your ability:

( ) Yes ( ) No Does the site contain any jurisdictional wetlands?
( ) Yes ( ) No Is any non-domestic sewage (i.e. industrial) to be generated?
( ) Yes ( ) No Is the site subject to approval by any other public agency?

****

I have read this application and certify that the information provided herein is true, complete, and correct. Authorized county and state officials are granted right of entry to conduct necessary inspections to determine compliance with applicable laws and rules. I understand that I am solely responsible for the proper identification and labeling of all property lines and corners and making the site accessible so that a complete site evaluation can be performed.

Signature: William Larry Feimster 12-17-21

Property owner or owner's legal representative signature (SIGNATURE REQUIRED) DATE

IREDELL COUNTY DEPARTMENT OF ENVIRONMENTAL HEALTH

DOCUMENTATION TO AUTHORIZE AN OWNER'S LEGAL REPRESENTATIVE

(Check and sign only ONE of the options below)

☐ **1. * APPLICANT AND OWNER ARE THE SAME. *** (*Sign here*) William Tony Forrester

Applications for permits require the "signature of the owner or owner's legal representative" (15A NCAC 18A .1937). If the owner does not sign the application himself or herself, they can submit any one of the following documents to designate their legal representative: *Power of Attorney; Real Estate Contract; Estate executor; Bankruptcy trustee; Court ordered guardianship* In the absence of the above documentation, the property owner may provide the local health department with documentation that designates a legal representative. A property owner may:
Complete this form to document his or her legal representative, or provide his or her own form that contains the information in this form. If there are multiple property owners, then all property owners must sign the form that designates a legal representative.
By signing a form that designates a legal representative for purposes of 15A NCAC 18A .1937, the property owner authorizes that representative to act on their behalf in matters pertaining to the application and permitting process, including signing or receiving any application, document or permit. The owner retains full responsibility to meet all permit conditions specified by the local health department.

☐ **2.** I, _____, am the legal owner(s) of the property located at _____, identified as PIN (Parcel Identification Number)_____, located in Iredell County, North Carolina.

I do hereby authorize (**print legal representative/company name**) _____, _____, to act as an agent on my behalf in applying for/signing/obtaining any of the documents described below.

- Application for Improvement Permit (IP) / Authorization to Construct (AC)
- Improvement Permit (IP) / Authorization to Construct (AC)
- Application for soil-site evaluation (new/repair)
- Application/permit for private drinking water well/well abandonment
- Application for Compliance Inspection

I agree to abide by all decisions and/or conditions between the legal representative acting on my behalf and the Iredell County Department of Public Health, Environmental Health Division.

_____ _____
Signature of Owner(s) Date

Mooresville - Environmental Health
barbara.nebel@co.iredell.nc.us
Fax: 704-662-3239
610 E. Center Avenue, Mooresville, NC 28115


Statesville - Environmental Health
ronda.hart@co.iredell.nc.us
Fax: 704-871-3483
349 N. Center Street, Statesville, NC 28677

IREDELL COUNTY HEALTH DEPARTMENT

ENVIRONMENTAL HEALTH DIVISION

PAGE 2: ***SITE PLAN WORKSHEET***

SEE THE "SAMPLE SITE PLAN" BELOW. ***INCOMPLETE SITE PLANS WILL BE RETURNED TO YOU FOR COMPLETION AND MAY RESULT IN A DELAY IN THE ISSUANCE OF YOUR SEPTIC SYSTEM PERMIT!!!***

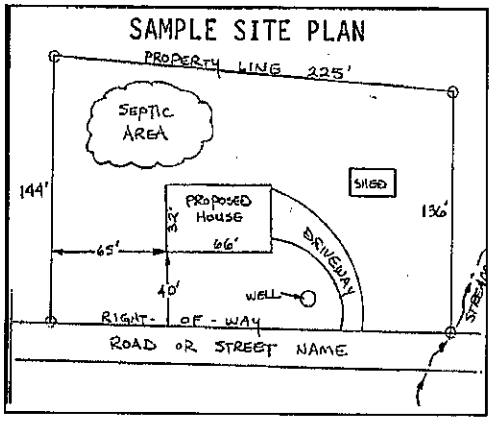

Place an (X) beside each item as you complete the site plan:


- ( ) Property Line measurements are clearly identified
- ( ) All proposed structures are indicated
- ( ) Front and side setbacks from property line
- ( ) Preferred driveway location and well location
- ( ) Area you prefer your septic system to be placed
- ( ) North arrow, or other sufficient indicator of direction


Circle N/A on the following if appropriate:

Location of septic systems and wells within 100' of your property	N/A
Location of easements and rights of ways on your property	N/A
Location of any designated wetlands on the property	N/A

USE THIS SPACE TO DRAW YOUR SITE PLAN

Show: proposed house or business footprint, wells, water lines, patios, pools and decks, and any other item that will occupy space on the site

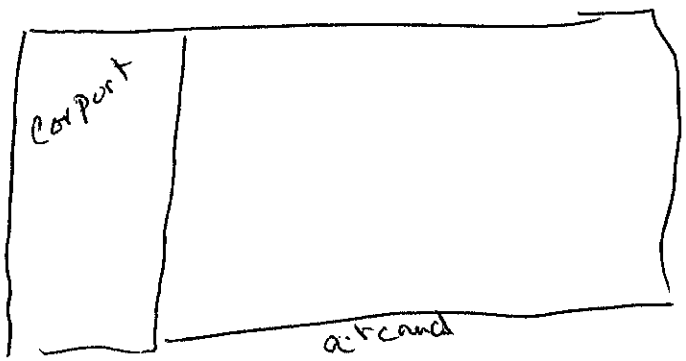

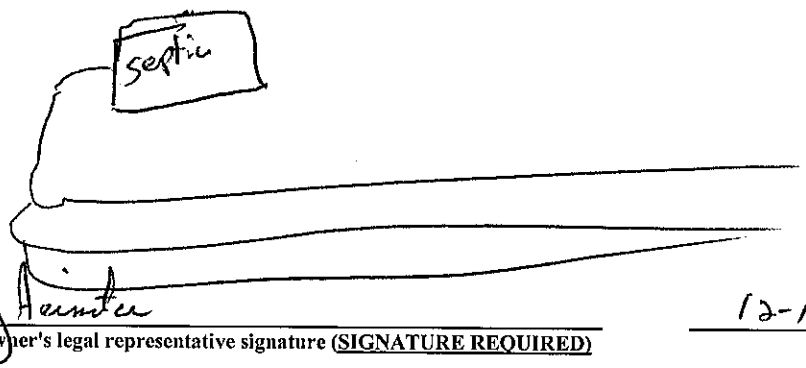

Signature: William Larry Hamter

Property owner or owner's legal representative signature (SIGNATURE REQUIRED)

12-17-21

DATE