IREDELL COUNTY HEALTH DEPARTMENT

STATESVILLE 704-878-5305 MOORESVILLE 704-664-5281

IMPROVEMENT PERMIT / AUTHORIZATION TO CONSTRUCT / OPERATION PERMIT / EXISTING SYSTEM INSPECTION

PERMIT # 158332 PIN # 4706083175 DATE 11-17-09

OWNER or APPLICANT Sible Smith PHONE: Business 704-585-2773 Home:

OWNER or APPLICANT ADDRESS 425E Lackey Farm

LOCATION / DIRECTIONS Hwy 64E, (R) on Lackey Farm, Lot on (L)

SUBDIVISION n/a BLOCK / SECTION n/a LOT # n/a LOT AREA 1.607 DESIGN FLOW 360 L.T.A.R. .25

Septic Tank 1000 Gallons: STB 760 Date 5-2-9

Pump Tank ____ Gallons: P T ____ Date ____

Pump Make ____ Model ____ Serial # ____

Nitrification Field No Fields 1 No Lines 3 Linear Feet 120

Trench Width 36" Max. Trench Bottom Depth 32" Gravel Depth n/a

☒ New System ☐ Repair ☐ Expansion System Type I II (III) IV V VI

System Description: 25% Reduction

Repair System Description: 25% Reduction

Maintenance Agreement Required ☐ YES ☒ NO

☒ GRAVITY ☐ PRESSURE

☒ Residence No. Bedrooms 3

☐ Business No. Persons ____

☐ Other No. Employees ____

☐ Slab ☒ Crawl Space

☐ Basement w/plumbing ☐ Basement w/o plumbing


Water Supply: ☐ Private ☒ Public ☐ Community

Comments / Conditions


Comments / Conditions

Red Filter

INITIAL SITE SKETCH

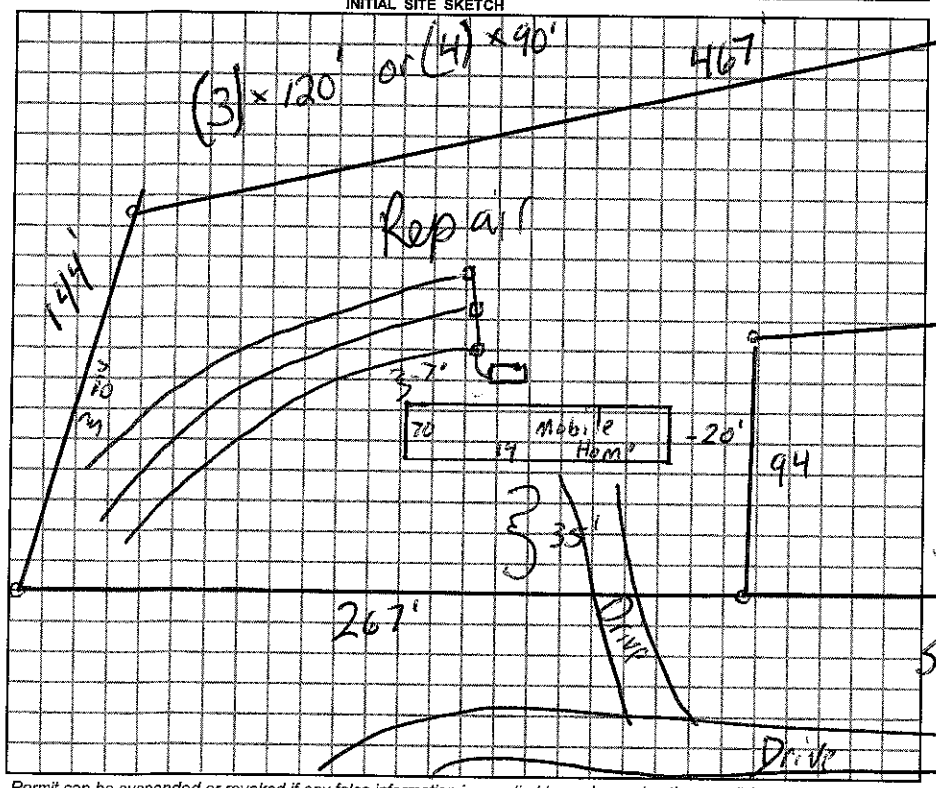

AS BUILT SKETCH

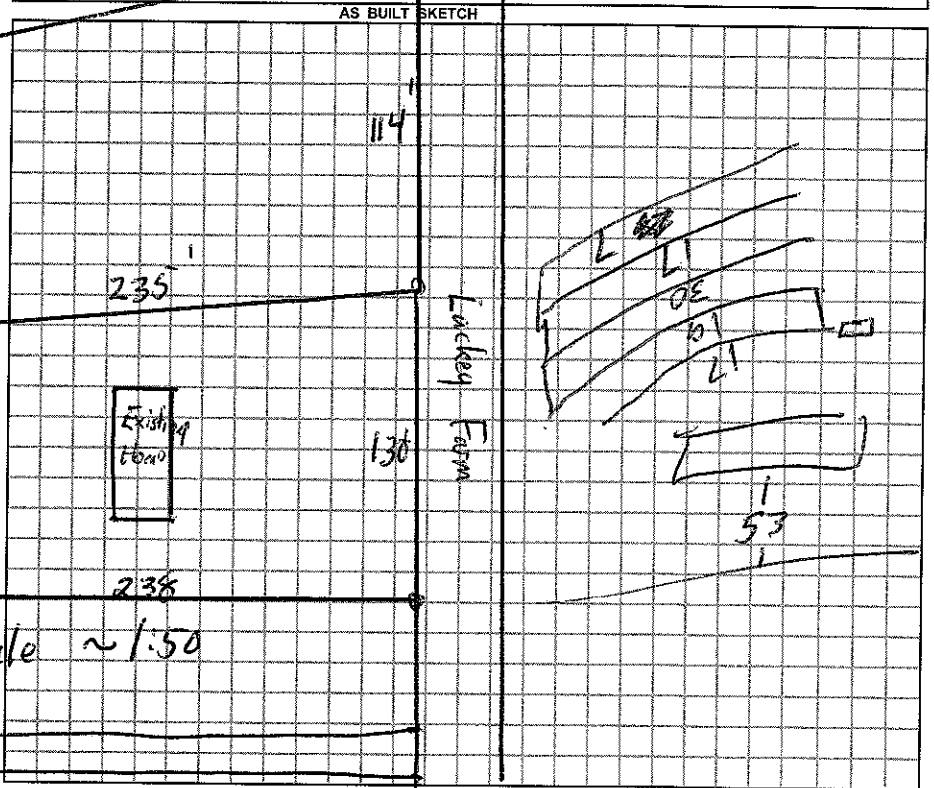

Permit can be suspended or revoked if any false information is supplied toward securing the permit / any unauthorized changes are made to the site / any unauthorized changes are made in the installation of the system.

☐ *IMPROVEMENT PERMIT w / plat valid without expiration.* ☒ *IMPROVEMENT PERMIT w / site plan valid for 60 mos.* ☒ *AUTHORIZATION TO CONSTRUCT valid for period equal to IMPROVEMENT PERMIT-not to exceed 60 mo.*

Owner / Applicant Signature: [signature] Date 11-17-09

Improvement Permit by: [signature] Date 11-17-09

Authorzation to Construct by: [signature] Date 11-17-09

Installed by: A-1 Backhoe

Operation Permit by: [signature] Date: 11-17-09

Existing System Inspected by: ____ Date: ____

YOU SHOULD CONTACT A LOCATOR SERVICE PRIOR TO ANY EXCAVATION.

WHITE COPY Environmental Health YELLOW COPY (Final) Owner / Applicant PINK COPY (Initial) Owner / Applicant