* Repair

IREDELL COUNTY HEALTH DEPARTMENT

STATESVILLE 704-878-5305 MOORESVILLE 704-664-5281

IMPROVEMENT PERMIT / AUTHORIZATION TO CONSTRUCT / OPERATION PERMIT / EXISTING SYSTEM INSPECTION

PERMIT # Repair PIN # 4706-08-8028 DATE 9 March 10

OWNER or APPLICANT Joel Gene Bost PHONE: Business Home: (704) 585-2210

OWNER or APPLICANT ADDRESS 430 East Lackey Farm Rd. Stony Point

LOCATION / DIRECTIONS Hwy 90 W TL East Lackey Farm Rd. 6th Home on Left.

SUBDIVISION BLOCK / SECTION LOT # 14,15 LOT AREA DESIGN FLOW 450 gpd L.T.A.R. 0.37 gpd/sf

Septic Tank Exist. Gallons: STB Date

Pump Tank Gallons: P T Date

Pump Make Model Serial #

Nitrification Field No Fields 1 No Lines 5 Linear Feet 400

Trench Width 36" Max. Trench Bottom Depth 36" Gravel Depth

☐ New System ☑ Repair ☐ Expansion System Type I II (III) IV V VI

System Description:

Repair System Description: 25% Reduction

Maintenance Agreement Required ☐ YES ☑ NO

☑ GRAVITY ☐ PRESSURE

☑ Residence No. Bedrooms 4

☐ Business No. Persons

☐ Other No. Employees

☐ Slab ☐ Crawl Space


☐ Basement w/plumbing ☑ Basement w/o plumbing

Water Supply: ☑ Private ☑ Public ☐ Community

Comments / Conditions: Plumb washing machine into septic system. Replace Tee in Tank. Bridge across the old washing machine drain, using minimum 3" SCH 40 PVC

Comments / Conditions: Existing Tee O.K.

INITIAL SITE SKETCH

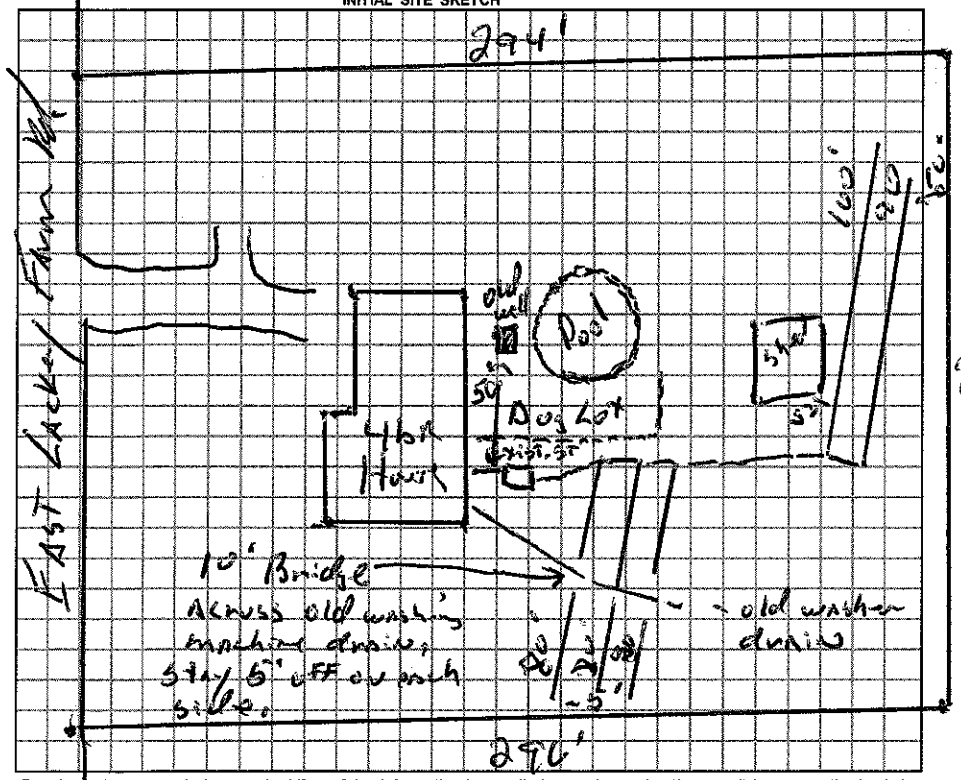

AS BUILT SKETCH

Installed as Drawn.

Due to location of washing machine drain - only 350' installed.

Permit can be suspended or revoked if any false information is supplied toward securing the permit / any unauthorized changes are made to the site / any unauthorized changes are made in the installation of the system.

☐ *IMPROVEMENT PERMIT w / plat valid without expiration.* ☐ *IMPROVEMENT PERMIT w / site plan valid for 60 mos.* ☑ *AUTHORIZATION TO CONSTRUCT valid for period equal to IMPROVEMENT PERMIT-not to exceed 60 mo.*

Owner / Applicant Signature: Joel R Bost Date 3-23-10

Improvement Permit by: Date

Authorzation to Construct by: R.S. Date 9 March 10

Installed by: Alexander Precast

Operation Permit by: R.S. Date: 20 May 10

Existing System Inspected by: Date:

YOU SHOULD CONTACT A LOCATOR SERVICE PRIOR TO ANY EXCAVATION.

WHITE COPY Environmental Health YELLOW COPY (Final) Owner / Applicant PINK COPY (Initial) Owner / Applicant