12187

IREDELL COUNTY HEALTH DEPARTMENT

(SEPTIC TANK) IMPROVEMENTS PERMIT AND CERTIFICATE OF COMPLETION

(Ground Absorption Sewage Disposal System -- G. S. Chapter 130-Article 13C)

OWNER OR CONTRACTOR MARK S. FOY DATE 12-4-90 PERMIT NO. 9T-1-A-12.

PHONE: Business _____ Home _____

LOCATION Hwy 90 W-T. on Left from Rd. (just past Battle School) mobile home, Lot #52 House on left.

SUBDIVISION NAME _____ LOT NO. _____ SECTION OR BLOCK NO. _____ S. R. No. _____


House ( ) Mobile Home (✓) Business ( ) Other _____

No. Bedrooms 2 No. Bathrooms 2

Garbage Disposal Unit Yes ( ) No (✓)
Auto. Dishwasher Yes ( ) No (✓)
Auto. Wash. Machine Yes (✓) No ( )
Site Suitable Yes (✓) No ( )
Lot Area Ample

Character & Porosity of Soil Prop. Suitable
Percolation Rate Satisfactory
Topography Level
Depth to Water Table 12"+
Rock or other impervious formations None observed

_____ Basement with Plumbing _____ Basement without Plumbing ✓ No Basement

 

Size of Tank 1000 Gals.
Nitrification Field:
No. of Lines 3
Sq. Ft. 720 Linear Ft. 240
Depth of Stone in Lines 12"
Water Supply: Individual ( )
Public (✓)

Installed by Tommy Cotton

I understand and agree to install septic tank system as specified on this Improvements Permit.

Signed: _____

Plan of System

IMPROVEMENTS PERMIT BY Steve Braun

COMMENTS: _____

CERTIFICATE OF COMPLETION BY Steve Braun DATE 12-4-90

EXISTING SYSTEM CHECKED BY: _____ DATE _____

CONSTRUCTION MUST COMPLY WITH ALL OTHER APPLICABLE STATE AND LOCAL REGULATIONS.

Permit is VOID if any unauthorized changes are made in installation of system and/or if any false information is supplied in making Improvements Permit.

Health Dept. Copy: White Inspection Dept. Copy: Yellow Sanitarian's Copy: Pink Owner's Copy: Gold