IREDELL COUNTY HEALTH DEPARTMENT

Statesville Phone TR 3-7271 Mooresville Phone NO 3-1271

PERMIT TO INSTALL SEPTIC TANK

Permit No. _____ Permit Date 3-31 1969

Owner Allie Robertson Address Statesville N.C.

Installed By H. K. Hedrick Address Statesville


Location of Property Hwy 10 W. past Scotts School Left on Rd no. 1539 1st new brick house on Left.

Tank		Capacity		Length of Lines		Fixtures	
Block	( )	1000	(✓)	225'	(✓)	No. of Baths	( )
Precast	( )	1250	( )	250'	( )	Dishwasher	( )
		1500	( )	Other _____		Garbage Grdr.	( )
		Other _____				Other _____	

NOTIFY HEALTH DEPARTMENT AT LEAST EIGHT HOURS BEFORE TANK IS TO BE INSPECTED.

Final Inspection 3-31 1969 Approved (✓) Disapproved ( )

Remarks Stony Point Aerial system

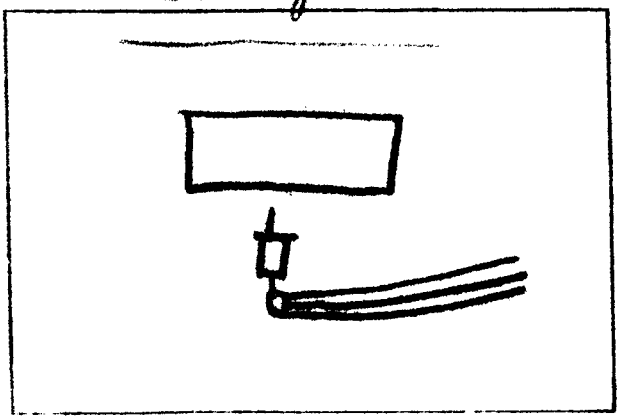

Sketch of Installation

Andrew J. Hutchinson R.S.

Sanitarian