IREDELL COUNTY HEALTH DEPARTMENT

Statesville Office (704) 878-5305 Mooresville Office (704) 660-3625 PERMIT # 178166

IMPROVEMENT PERMIT / AUTHORIZATION TO CONSTRUCT / OPERATION PERMIT / EXISTING SYSTEM

PIN # 4706 09 96 75

APPLICANT: Larry & Kenneth Deal APPLICANT ADDRESS: 4873 Taylorsville Hwy

SITE ADDRESS: 4873 Taylorsville Hwy PHONE: 704-907-4045 ALT. PHONE:

SITE DIRECTIONS: Hwy 90 towards Taylorsville. On corner of Taylorsville Hwy and E. Lackey Farm

SUBDIVISION: n/a SECTION: n/a LOT # n/a LOT AREA: 2.0 DESIGN FLOW: 360 L.T.A.R.: .3

Septic Tank 1000 (gal) STB 760 Date 6-1-12
Pump Tank (gal) PT Date
Pump Make Model Serial #
Nitrification Fields 1 # Lines 3 Linear Ft: 300
Trench Width 36" Max. Trench Bottom Depth 36" Gravel Depth n/a


☐ New System ☒ Repair ☐ Expansion System Type: I II (III) IV V VI
System Description:
Repair System Description: 25% Reduction Gravity
Maintenance Agreement Required: ☐ YES ☒ NO
☒ GRAVITY ☐ PRESSURE

☒ Residence No. Bedrooms 3
☐ Business No. Persons
☐ Other No. Employees
☐ Slab ☐ Crawl Space
☐ Basement w/plumbing ☒ Basement w/o plumbing


Water Supply: ☐ Private ☒ Public ☐ Community

Comments / Conditions:

INITIAL SITE SKETCH

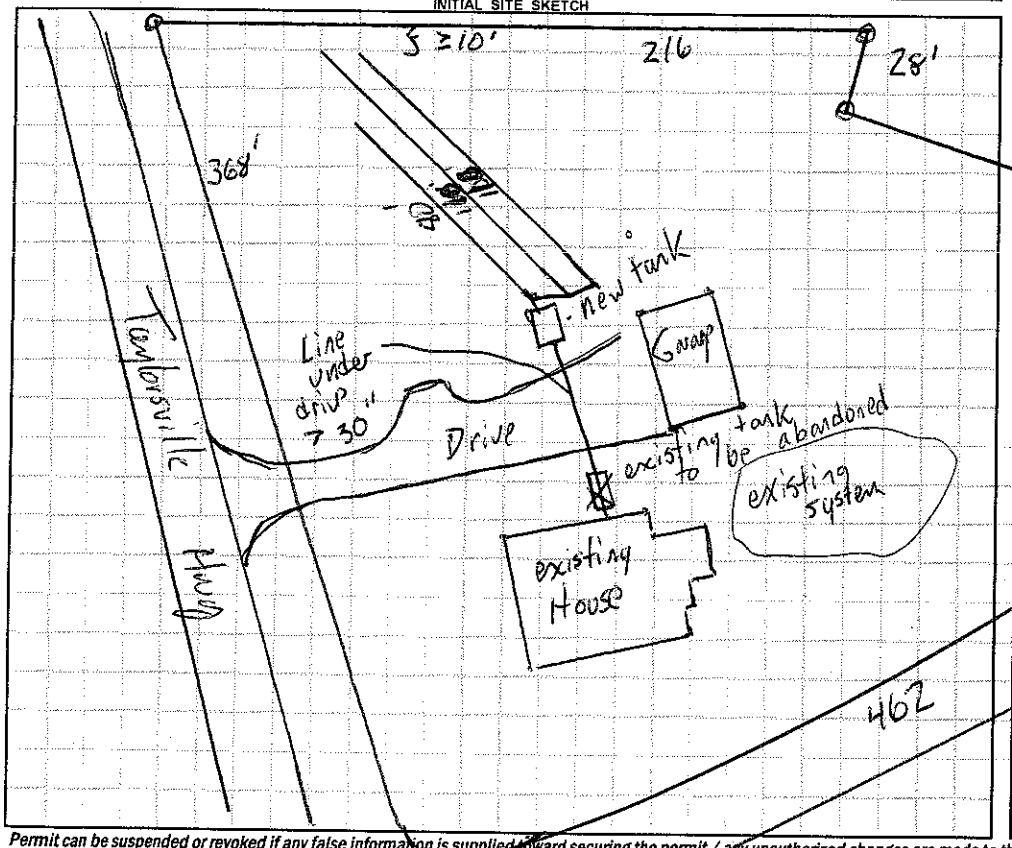

AS BUILT SKETCH

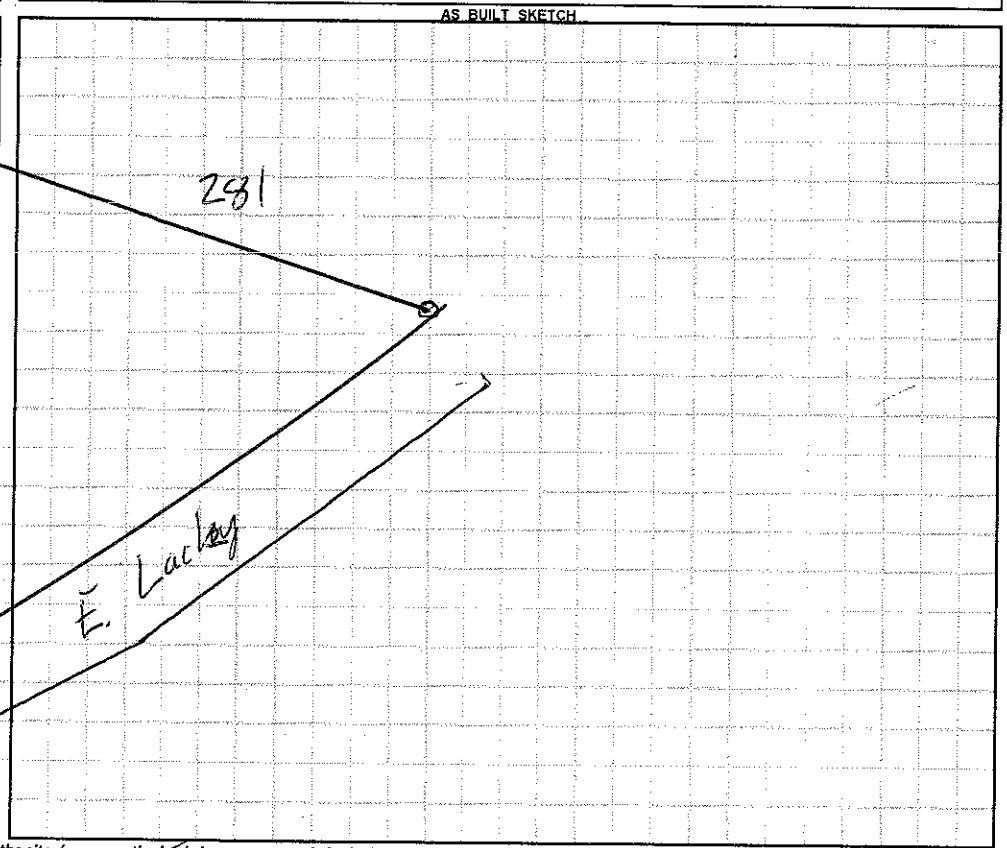

Permit can be suspended or revoked if any false information is supplied toward securing the permit / any unauthorized changes are made to the site / any unauthorized changes are made in the installation of the system. **CONTACT A LOCATOR SERVICE PRIOR TO ANY EXCAVATION**

☐ **IMPROVEMENT PERMIT** *with plat valid without expiration.* ☒ **IMPROVEMENT PERMIT** *with site plan valid for 60 mos.* ☒ **AUTHORIZATION TO CONSTRUCT** *valid for period equal to IMPROVEMENT PERMIT--not to exceed 60 mo.*

Owner / Applicant Signature: Kenneth R Deal Date: Installed by:

IMPROVEMENT PERMIT by: James Date: 4-19-13 OPERATION PERMIT by: James Date: 4-19-13

AUTHORIZATION TO CONSTRUCT by: James Date: 4-19-13 Existing System Inspected by: James Date: 4-19-13

Health Dept. Copy - WHITE Applicant (Final Approval) - YELLOW Applicant (Conditional Approval) - PINK