IREDELL COUNTY HEALTH DEPARTMENT

STATESVILLE 704-878-5305 MOORESVILLE 704-664-5281

IMPROVEMENT PERMIT / CERTIFICATE OF COMPLETION / OPERATION PERMIT / EXISTING SYSTEM INSPECTION

PROPERTY DESCRIPTION NO. Repair DATE 9-23-93 TAX MAP NO. Repair

OWNER OR CONTRACTOR Glenn Moore (Mrs.) PHONE: Business _____ Home (704) 921-5131

ADDRESS 4266 Linda Lane, Lilburn, Ga. 30247

LOCATION I40W TR Hwy 90W, 6th house on L after Scotts Elementary School.

SUBDIVISION NA BLOCK / SECTION _____ LOT — LOT AREA — SITE CLASS. Existing L.T.A.R. →

Water Supply: ☑ Individual ☐ Community ☐ Public Well

Septic Tank: 1000 Gallons; STB 760 Date 9-4-93

Pump Tank: — Gallons; PT — Date —

Nitrification Field: No Fields Existing ~~Square Feet~~ ~~Linear Feet~~ →

No Lines _____ Trench Width _____ Trench Depth _____ Gravel Depth _____

☐ New System ☐ Repair System Type: I. II. III. IV. V. VI

System Description: _____

Repair System Description: _____

Maintenance Agreement Required: ☐ Yes ☐ No

☑ House/Mod. Home ☐ Mobile Home ☐ Business ☐ Other

No. Bedrooms 5 No. Bathrooms 2 No. Employees —

Garbage Disposal: ☑ Yes ☐ No

Auto. Dishwasher: ☐ Yes ☐ No


Auto. Washing Machine: ☐ Yes ☐ No

Other _____

☐ Slab ☐ Crawl Space ☐ Basement w/plumbing ☐ Basement wo/plumbing

Comments Abandon existing septic Tank. Install new septic tank. Install washing machine drain into new septic tank. Completely crush existing septic tank and fill in. Tie in all plumbing into septic tank. (sink drain drains to surface as-well.

INITIAL SITE SKETCH

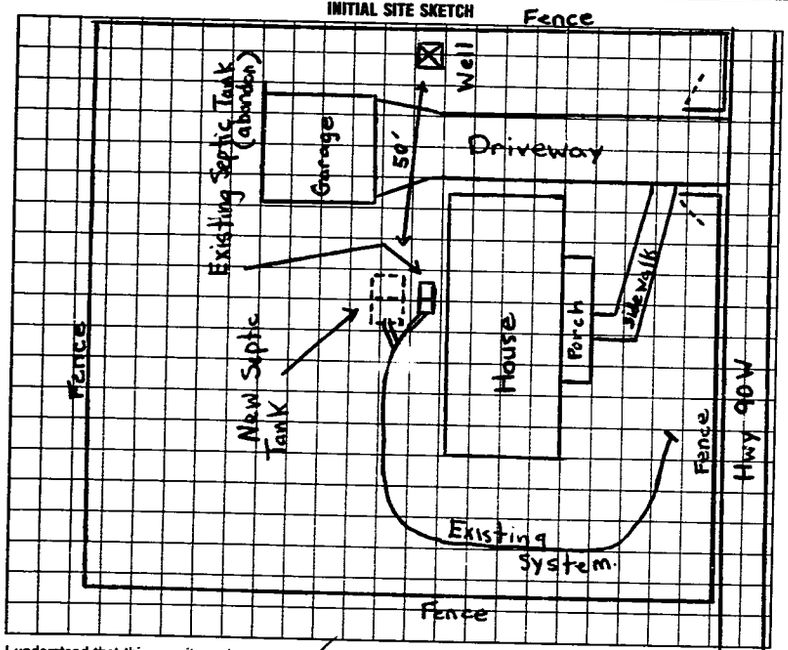

AS BUILT SKETCH

* Tank installed and connected into old draintines.
* Drain line for washing machine installed into septic tank.

SAME AS INITIAL SKETCH

I understand that this permit can be suspended or revoked if any false information is supplied toward securing the permit/any unauthorized changes are made to the site/any unauthorized changes are made in the installation of the system. Improvement Permit is valid for 60 months from date of issuance.

X Signed: Sherry V Parker

Improvement Permit by: Michael J. Dennis date 9-23-93

Existing System Inspection by: _____ date _____

Installed by: Miller & Sons Backhoe

Certificate of Completion by: Michael J. Dennis date 11-10-93

Operation Permit by: _____ date _____

HEALTH DEPT. COPY: WHITE INSPECTION COPY (FINAL): GREEN OWNER COPY (FINAL): YELLOW INSPECTION COPY (INITIAL): PINK OWNER COPY (INITIAL): GOLD