IREDELL COUNTY HEALTH DEPARTMENT

(SEPTIC TANK) IMPROVEMENTS PERMIT AND CERTIFICATE OF COMPLETION
(Ground Absorption Sewage Disposal System – G. S. Chapter 130-Article 13C)

OWNER OR CONTRACTOR Aaron Weaver DATE 2-23-76 PERMIT NO. _____

PHONE: Business _____ Home _____

LOCATION Hwy # 90 Above Don Murdocks Ser Sta. T.L. on Rd 1538. Bear to L. House on Rt. Near end of Rd. S. R. No. _____


SUBDIVISION NAME _____ LOT NO. _____ SECTION OR BLOCK NO. _____

House (✓) Mobile Home ( ) Business ( ) Other _____

No. Bedrooms 3 No. Bathrooms 2

Garbage Disposal Unit	Yes ( )	No (✓)	Character & Porosity of Soil	Cecil Clay	
Auto. Dishwasher	Yes ( )	No (✓)	Percolation Rate		
Auto. Wash. Machine	Yes (✓)	No ( )	Topography	Slight Slope	
Site Suitable	Yes (✓)	No ( )	Depth to Water Table	Low	
			Rock or other impervious formations	None	

Lot Area 1 Acre

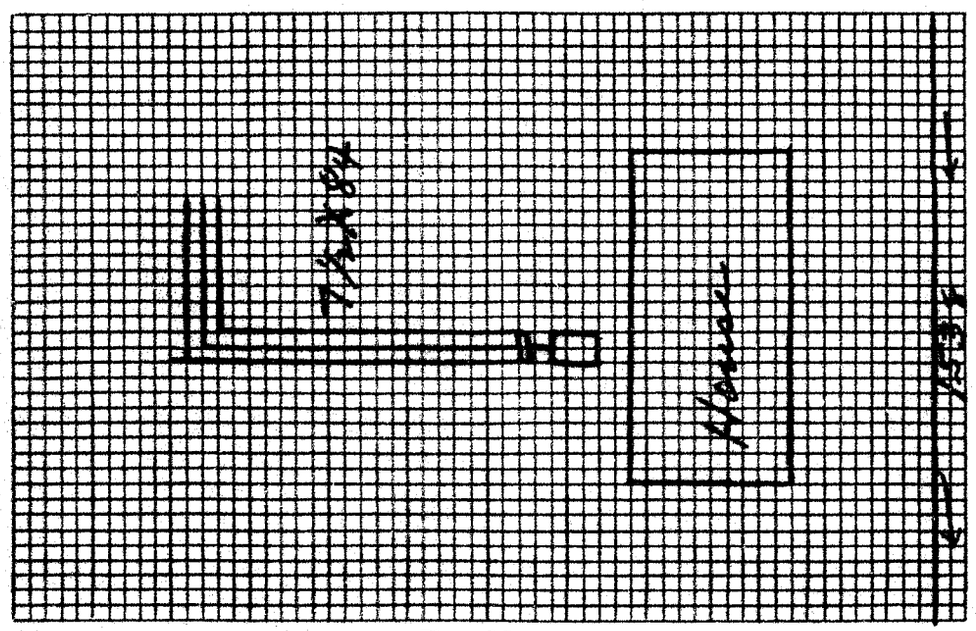

Plot of System

Size of Tank 1000 Gals.

Nitrification Field:
No. of Lines 3
Sq. Ft. 625 Linear Ft. 250
Depth of Stone in Lines 10"

Water Supply: Individual ( )
Public (✓)

Installed by John Mercer

IMPROVEMENTS PERMIT BY _____

COMMENTS: Tank Not Put in as laid out.
Downspouts Must to be Diverted away from Tank + Lines.

CERTIFICATE OF COMPLETION BY E. A. Stevenson DATE 2-23-76

CONSTRUCTION MUST COMPLY WITH ALL OTHER APPLICABLE STATE AND LOCAL REGULATIONS.

Health Dept. Copy: White Inspection Dept. Copy: Yellow Sanitarian's Copy: Pink Owner's Copy: Gold