IREDELL COUNTY HEALTH DEPARTMENT

STATESVILLE 704-878-5305 (CL) MOORESVILLE 704-664-5281

IMPROVEMENT PERMIT / AUTHORIZATION TO CONSTRUCT / OPERATION PERMIT / EXISTING SYSTEM INSPECTION

PERMIT# 109694 PIN# ~~4706-33-3368.20~~ 4706-33-8524 DATE 12/20/02

OWNER OR CONTRACTOR Jimmy Goss PHONE: Business 704-791-3147 Home —

ADDRESS P.O. Box 142 Landis, N.C. 28088

LOCATION Hwy 90, (L) Robertson Rd, (L) Ridge Run at end on left

SUBDIVISION Ridgewest Est. BLOCK / SECTION 2 LOT 20 LOT AREA .99 Ac SITE CLASS. P5 DESIGN FLOW 360 L.T.A.R. .35

Septic Tank: 4000 Gallons; ST8 794 Date 10-14-01

Pump Tank: ____ Gallons; PT ____ Date ____

Pump Make: ____ Model ____ Serial No. ____

Nitrification Field: No Fields 1 Square Feet 1029 Linear Feet 345

No Lines 5 ~~4~~ Trench Width 36" Max Trench Bottom Depth 32" Gravel Depth 12"

[X] New System [ ] Repair System Type: I (II) III, IV, V, VI

System Description: Gravity, Conventional

Repair System Description: Gravity, Conventional

Maintenance Agreement Required: [ ] Yes [X] No

[X] House/Mod. Home No. Bedrooms 3

[ ] Mobile Home No. Bathrooms 2.5

[ ] Business No. Employees ____

[ ] Other ____


[ ] Slab [X] Crawl Space [ ] Basement w/plumbing [ ] Basement wo/plumbing

Water Supply: [ ] Individual [X] Public [ ] Community


Comments/Conditions: (1) Install lines on Contour (2) maintain proper setbacks

Comments/Conditions: Zabel Filter & S.T. Marker Installed

INITIAL SITE SKETCH

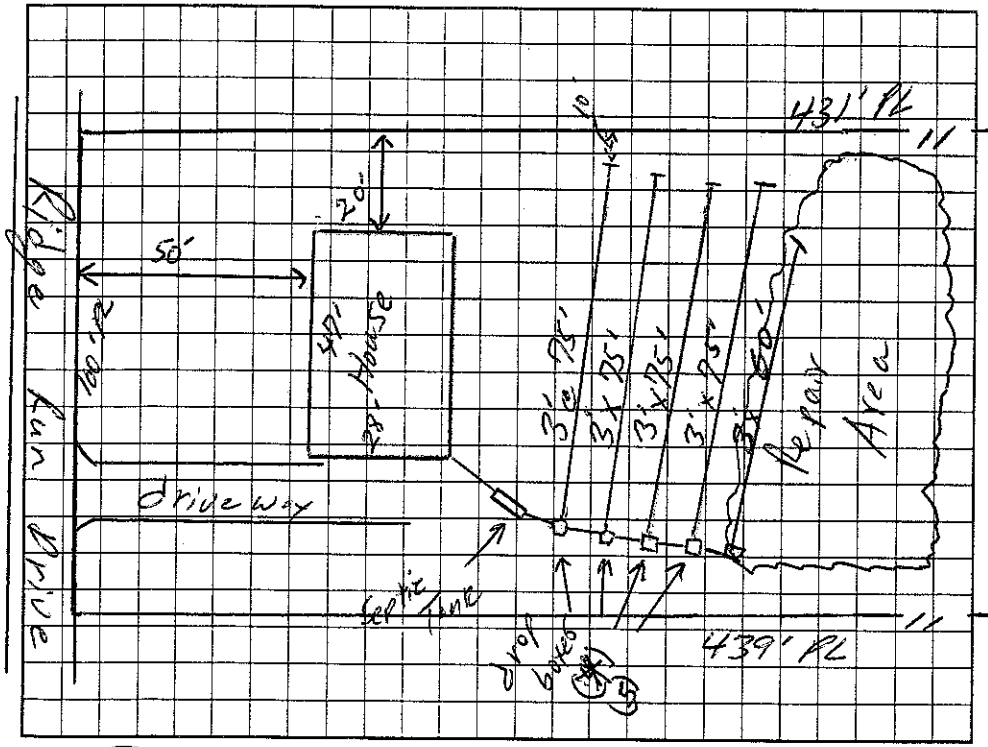

AS BUILT SKETCH

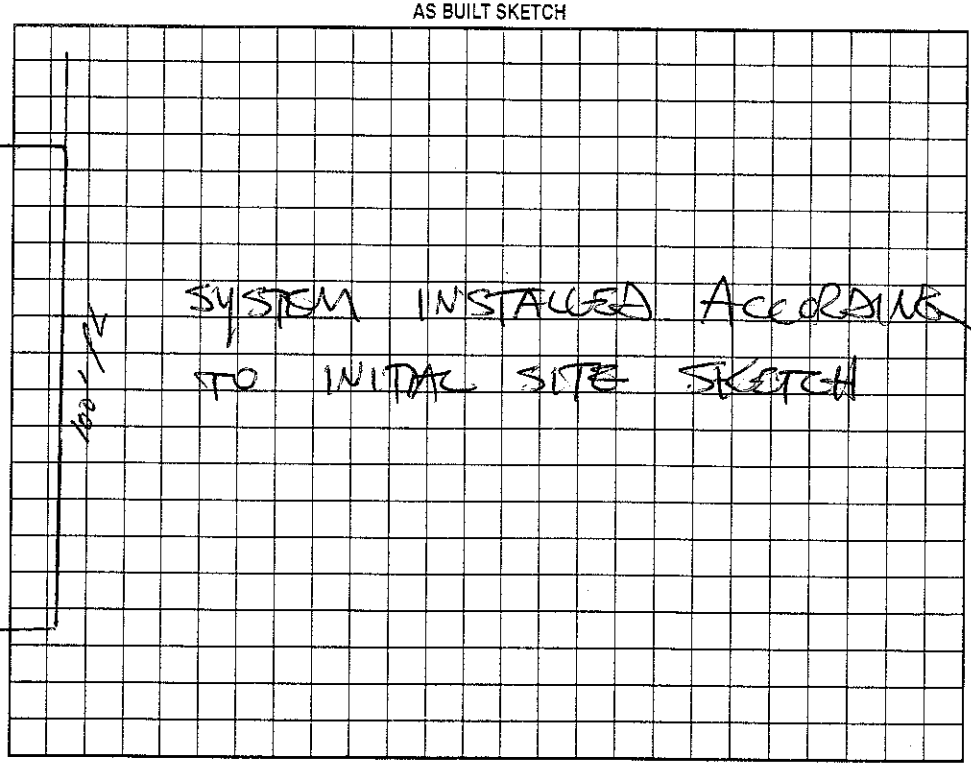

Permit can be suspended or revoked if any false information is supplied toward securing the permit/any unauthorized changes are made to the site/any unauthorized changes are made in the installation of the system. Improvement Permit with plat valid without expiration. Improvement Permit with site plan valid for sixty months. Authorization to Construct is valid for a period equal to that of Improvement Permit – not to exceed sixty months.

Signed: Jim Robuck date 1/23/03 Installed by: BADGER GRADING

Improvement Permit by: William O. Johnson date 12/20/02 Operation Permit by: STEVE HERRICK date 2-14-03

Authorization to Construct by: William O. Johnson date 12/20/02 Existing System Inspection by: ____ date ____

HEALTH DEPT. COPY: WHITE OWNER COPY (FINAL): YELLOW OWNER COPY (INITIAL): PINK