IREDELL COUNTY HEALTH DEPARTMENT

STATESVILLE 704-878-5305 CI MOORESVILLE 704-664-5281

IMPROVEMENT PERMIT / AUTHORIZATION TO CONSTRUCT / OPERATION PERMIT / EXISTING SYSTEM INSPECTION

PERMIT# 109693 PIN# ~~4706-33-3367.79~~ 4706-33-9527 DATE 12/24/02

OWNER OR CONTRACTOR Jimmy Goss PHONE: Business (704) 791-3147 Home —

ADDRESS P.O. Box 142 Landis, N.C. 28088

LOCATION Hwy 90, (2) Robertson Rd @ Ridge Run, on left

SUBDIVISION Edgewood Est BLOCK / SECTION 2 LOT 19 LOT AREA 0.981Ac SITE CLASS PS DESIGN FLOW 360 L.T.A.R. .30

Septic Tank: 1,000 Gallons; STB 312 Date 1-12-03
Pump Tank: — Gallons; PT — Date —
Pump Make: — Model — Serial No. —
Nitrification Field: No Fields 1 Square Feet 1,200 Linear Feet 400
No Lines 6 Trench Width 36 Max Trench Bottom Depth 32" Gravel Depth 12"

☒ New System ☐ Repair System Type: I (II) III. IV. V. VI
System Description: Gravity, Conventional
Repair System Description: Gravity, Conventional
Maintenance Agreement Required: ☐ Yes ☒ No


☒ House/Mod. Home No. Bedrooms 3
☐ Mobile Home No. Bathrooms ~~2~~ 2.5
☐ Business No. Employees —
☐ Other —
☐ Slab ☒ Crawl Space ☐ Basement w/plumbing ☐ Basement wo/plumbing

Water Supply: ☒ Individual ☐ Public ☐ Community


Comments:/Conditions: (1) Remove field terrace (2) Install Sub Surface drain as shown 44" deep to day light (3) Install flow divider Tee and (4) four drop boxes

Comments:/Conditions: LOWEST DRAINLINE INSPECTED 2-14-03-OK RSH
Line 2-5 Inspected 3-5-03 OK-WOJ
Top Line #1 OK - 3-12-03
Label Filter Installed, Drain Okay 3/13/03

INITIAL SITE SKETCH Scale 1" = 40'

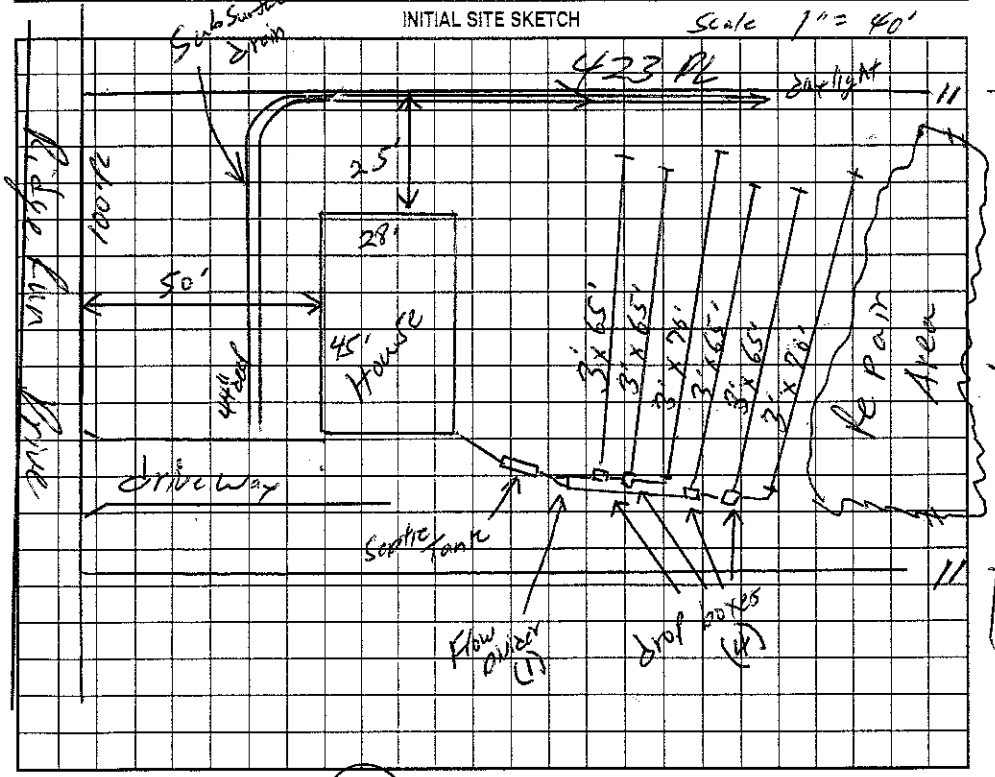

AS BUILT SKETCH

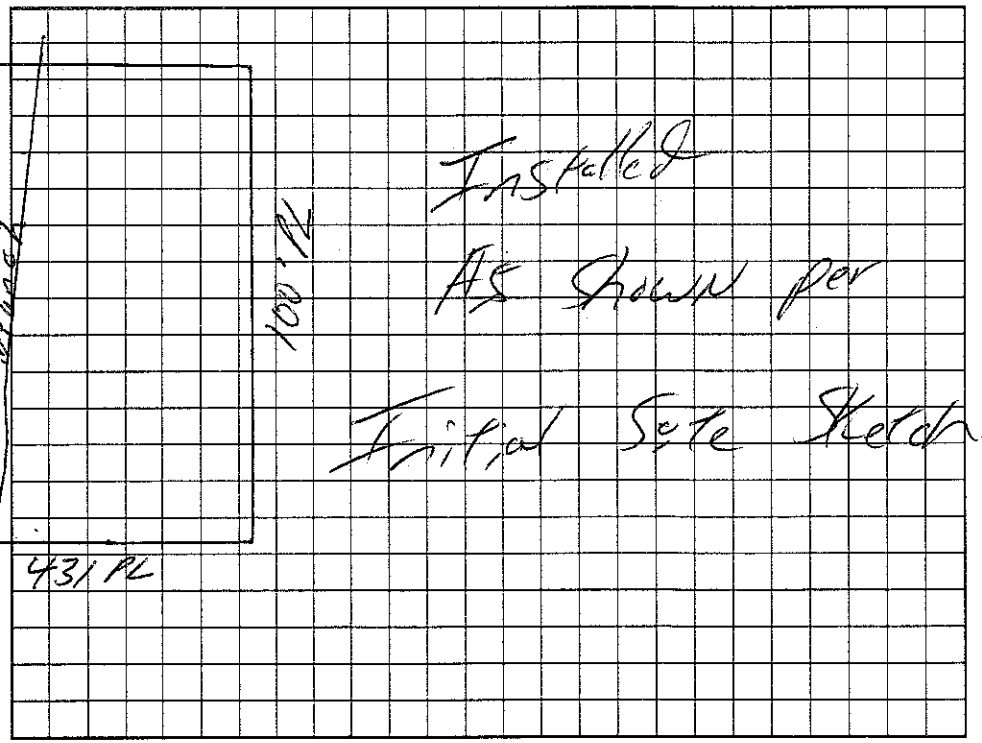

Permit can be suspended or revoked if any false information is supplied toward securing the permit/any unauthorized changes are made to the site/any unauthorized changes are made in the installation of the system. Improvement Permit with plat valid without expiration. Improvement Permit with site plan valid for sixty months. Authorization to Construct is valid for a period equal to that of Improvement Permit – not to exceed sixty months.

Signed: [redacted] Jim Robertson date 12/23/02 Installed by: Matt Young / Badger Const.

Improvement Permit by: William O. Johnson date 12/24/02 Operation Permit by: William O. Johnson date 3/13/03

Authorization to Construct by: William O. Johnson date 12/24/02 Existing System Inspection by: — date —

HEALTH DEPT. COPY: WHITE OWNER COPY (FINAL): YELLOW OWNER COPY (INITIAL): PINK