IREDELL COUNTY HEALTH DEPARTMENT

STATESVILLE 704-878-5305 MOORESVILLE 704-664-5281

IMPROVEMENT PERMIT / CERTIFICATE OF COMPLETION / OPERATION PERMIT / EXISTING SYSTEM INSPECTION

PROPERTY DESCRIPTION NO. 065887 DATE 4-18-97 TAX MAP NO. 4706382846 Watershed: ☐ Yes ☒ No

OWNER OR CONTRACTOR ED ST. CLAIR PHONE: Business _____ Home 871-8429

ADDRESS 105 SCOTTSVIEW DRIVE STONY POINT NC 28678

LOCATION NC 90 W TR SCOTTSVIEW DR, STRAIGHT AHEAD TO END, 2ND ON LEFT

SUBDIVISION ST. CLAIR MHP BLOCK / SECTION _____ LOT 10 LOT AREA MINIMUM SITE CLASS _____ DESIGN FLOW 240 L.T.A.R. EXISTING

Septic Tank: 1000 Gallons; STB _____ Date _____

Pump Tank: _____ Gallons; PT _____ Date _____

Pump Make: _____ Model _____ Serial No. _____

Nitrification Field: No Fields ____ Square Feet _____ Linear Feet EXISTING

No Lines _____ Trench Width _____ Max Trench Bottom Depth _____ Gravel Depth _____

☐ New System ☐ Repair System Type: I. II. III. IV. V. VI

System Description: CONV. GRAVITY

Repair System Description: _____

Maintenance Agreement Required: ☐ Yes ☒ No

☐ Slab ☒ Crawl Space ☐ Basement w/plumbing ☐ Basement wo/plumbing

☐ House/Mod. Home ☒ Mobile Home ☐ Business ☐ Other

No. Bedrooms 2 No. Bathrooms 2 No. Employees ____


Water Supply: ☐ Individual ☒ Community ☒ Public

Comments:

Comments:

INITIAL SITE SKETCH

AS BUILT SKETCH

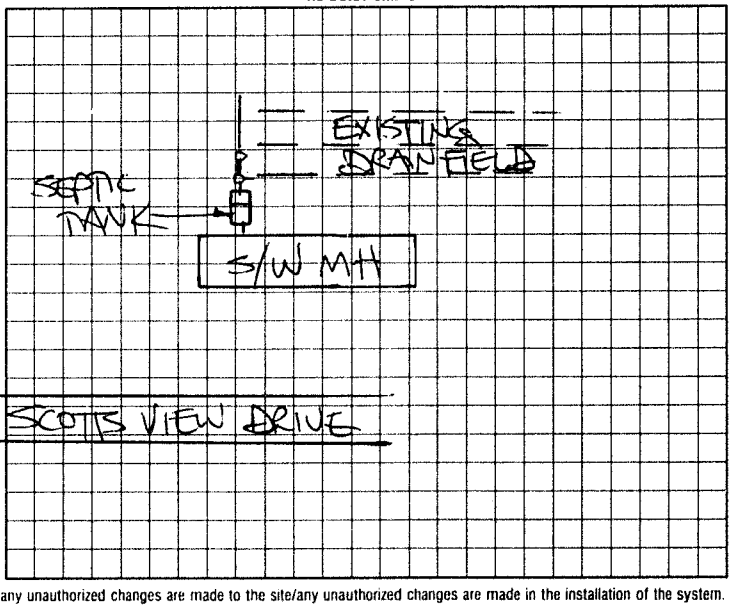

I understand that this permit can be suspended or revoked if any false information is supplied toward securing the permit/any unauthorized changes are made to the site/any unauthorized changes are made in the installation of the system.

Auth. to Const. is valid for a period equal to the validity of the IP not to exceed five years. IP w/site plan is valid five years.

Signed: _____ Installed by: _____

Improvement Permit by: EXISTING SYSTEM INSPECTION ; date _____ Certificate of Completion by: _____ date _____

Authorization to Construct

Existing System Inspection by: STEVE HEDRICK date 4-18-97 Operation Permit by: _____ date _____

XXXXXXXXXXXXXXXXX

HEALTH DEPT. COPY: WHITE INSPECTION COPY (FINAL): GREEN OWNER COPY (FINAL): YELLOW INSPECTION COPY (INITIAL): PINK OWNER COPY (INITIAL): GOLD