IREDELL COUNTY HEALTH DEPARTMENT

STATESVILLE 704-878-5305 MOORESVILLE 704-664-5281

IMPROVEMENT PERMIT / AUTHORIZATION TO CONSTRUCT / OPERATION PERMIT / EXISTING SYSTEM INSPECTION

DATE 3-17-99

PERMIT# Repair PIN#

OWNER OR CONTRACTOR David Stokes PHONE: Business Home 873-5373

ADDRESS 123 Marcell Rd Statesville

LOCATION 90(W) TL O'dell Stay Nt onto Marcell 3rd on (L)

SUBDIVISION BLOCK / SECTION LOT LOT AREA SITE CLASS P/S DESIGN FLOW 360 L.T.A.R.

Septic Tank: Existing Gallons; STB Date

Pump Tank: Gallons; PT Date

Pump Make: Model Serial No.

Nitrification Field: No Fields 1 Square Feet Linear Feet 150 ft

No Lines 4 Trench Width 36in Max Trench Bottom Depth 36in

☐ New System ☒ Repair System Type: I, II, III, IV, V, VI

System Description:

Repair System Description: Gravity Conventional

Maintenance Agreement Required: ☐ Yes ☒ No

☒ House/Mod. Home ☐ Mobile Home ☐ Business ☐ Other

No. Bedrooms 3 No. Bathrooms 2 No. Employees

☐ Slab ☒ Crawl Space ☐ Basement w/plumbing ☐ Basement wo/plumbing


Water Supply: ☐ Individual ☒ Public ☐ Community

Comments/Conditions: Install 4 lines on contour 18 in stone
Check sanitary T' tapbee if needed
Need to pump tank


Comments/Conditions

Installed as shown

INITIAL SITE SKETCH

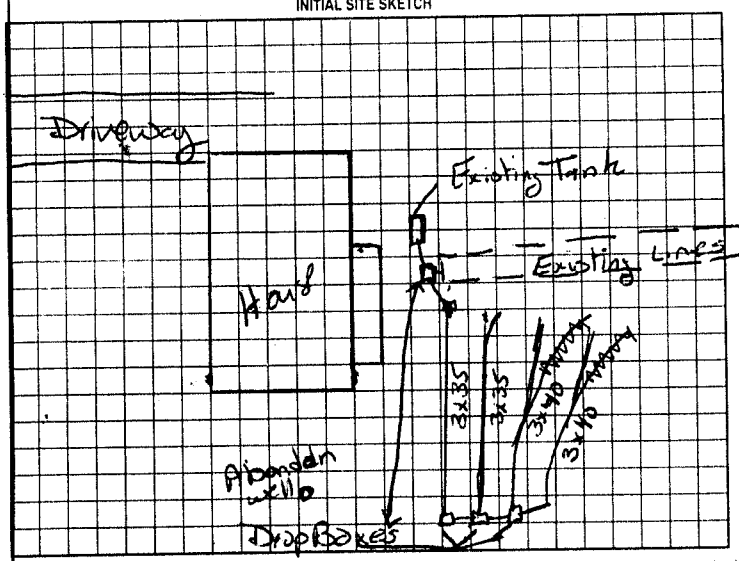

AS BUILT SKETCH

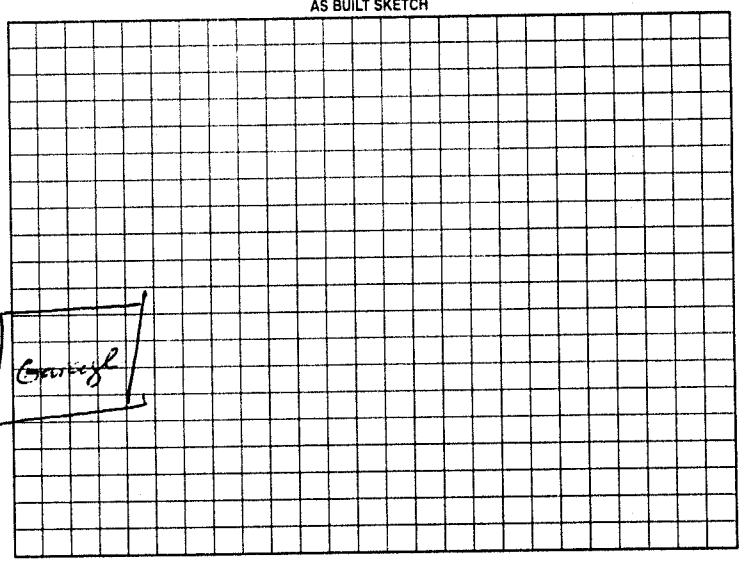

Permit can be suspended or revoked if any false information is supplied toward securing the permit/any unauthorized changes are made to the site/any unauthorized changes are made in the installation of the system. Improvement Permit with plat valid without expiration. Improvement Permit with site plan valid for sixty months. Authorization to Construct is valid for a period equal to that of Improvement Permit – not to exceed sixty months.

Signed: Christine Stephens date

Improvement Permit by: Mary C Ott RS date 3-17-99

Authorization to Construct by: Mary C Ott RS date 3-17-99

Installed by: Esker Elder

Operation Permit by: Mary C Ott RS date 5-4-99

Existing System Inspection by: date

HEALTH DEPT. COPY WHITE OWNER COPY (FINAL) YELLOW OWNER COPY (INITIAL) PINK