This permit voids permit dated 12/20/02 CI

IREDELL COUNTY HEALTH DEPARTMENT

STATESVILLE 704-878-5305 MOORESVILLE 704-664-5281

IMPROVEMENT PERMIT / AUTHORIZATION TO CONSTRUCT / OPERATION PERMIT / EXISTING SYSTEM INSPECTION

PERMIT# 109691 PIN# ~~4706-33-3364.78~~ 4706-43-0612 DATE 2/7/03

OWNER OR CONTRACTOR Jimmy Goss PHONE: Business (704) 791-3142 Home

ADDRESS P.O. Box 142 Landis N.C. 28088

LOCATION Hwy 90 @ Robertson Road, @ Ridge Run Drive on left

SUBDIVISION Ridgewest 1st BLOCK / SECTION 2 LOT 17(18) LOT AREA 1.792 Acres SITE CLASS. 85 DESIGN FLOW 480 L.T.A.R. .30 gpd/ft²

Septic Tank: 1000 Gallons; STB 794 Date 2-18-03

Pump Tank: ____ Gallons; PT ____ Date ____

Pump Make: ____ Model ____ Serial No. ____

Nitrification Field: No Fields 1 Square Feet 1600 Linear Feet 534

No Lines 5 Trench Width 36" Max Trench Bottom Depth 32" Gravel Depth 12"

☒ New System ☐ Repair System Type: I (II) III. IV. V. VI

System Description: Gravity, Conventional

Repair System Description: Gravity, 25% Reduction

Maintenance Agreement Required: ☐ Yes ☒ No

☒ House/Mod. Home ☐ Mobile Home ☐ Business ☐ Other

No. Bedrooms 4 No. Bathrooms 2½ No. Employees ____


☐ Slab ☒ Crawl Space ☐ Basement w/plumbing ☐ Basement wo/plumbing

Water Supply: ☐ Individual ☒ Public ☐ Community


Comments:/Conditions: (1) Install Subsurface drain 44" deep to daylight Keep Subsurface drain 15' off side of drainfield, 10 ft from upslope of drainfield (2) main tain proper setbacks (3) Okay to make driveway

Comments:/Conditions:

INITIAL SITE SKETCH

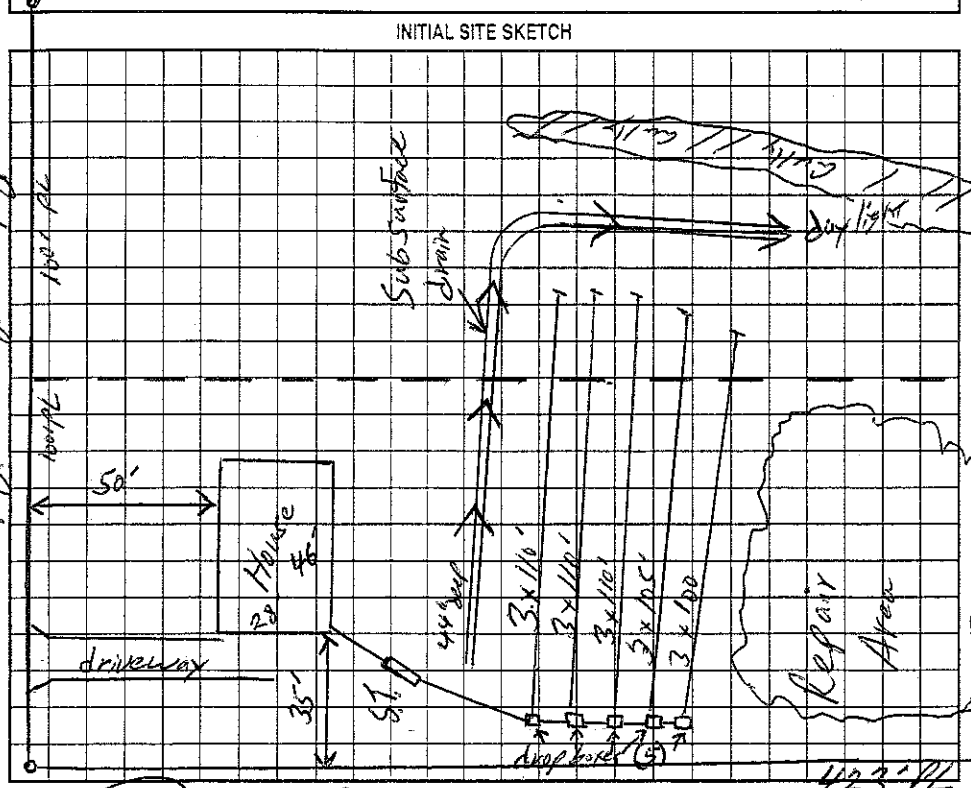

AS BUILT SKETCH

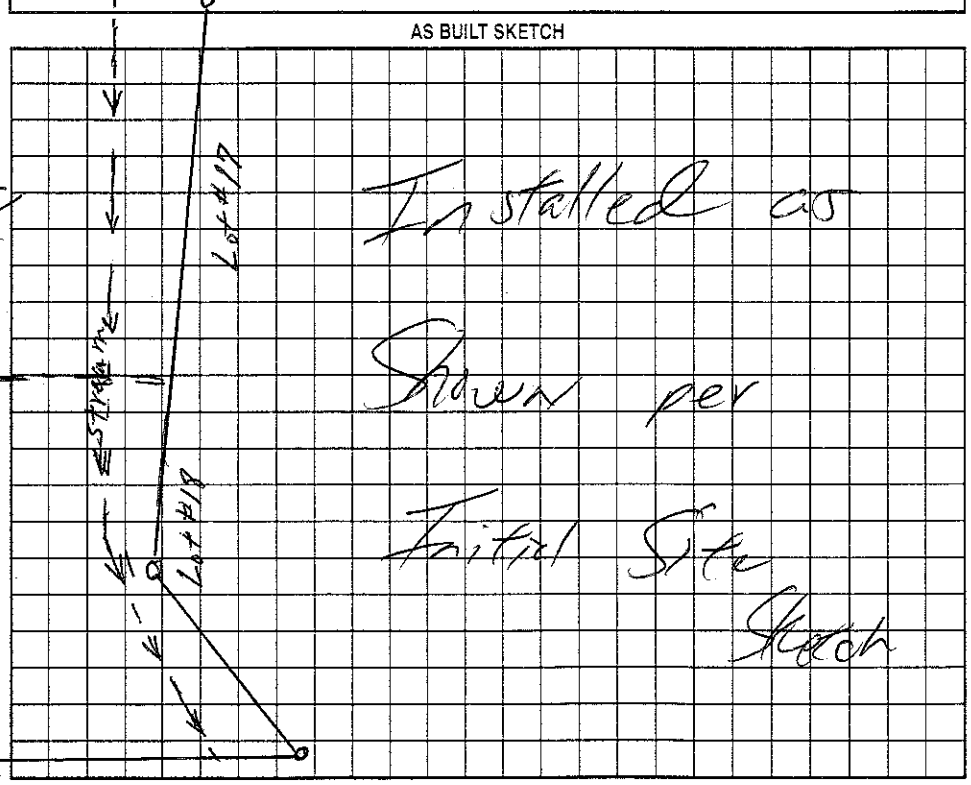

Permit can be suspended or revoked if any false information is supplied toward securing the permit/any unauthorized changes are made to the site/any unauthorized changes are made in the installation of the system. Improvement Permit with plat valid without expiration. Improvement Permit with site plan valid for sixty months. Authorization to Construct is valid for a period equal to that of Improvement Permit – not to exceed sixty months.

Signed: [signature] date ____ Installed by: Tommy Frye + Bisgay Const.

Improvement Permit by: William O Johnson date 2/7/03 Operation Permit by: William O Johnson date 3/26/03

Authorization to Construct by: William O Johnson date 2/7/03 Existing System Inspection by: ____ date ____

HEALTH DEPT. COPY: WHITE OWNER COPY (FINAL): YELLOW OWNER COPY (INITIAL): PINK