IREDELL COUNTY HEALTH DEPARTMENT

STATESVILLE 704-878-5305 CI MOORESVILLE 704-664-5281

CI

IMPROVEMENT PERMIT / AUTHORIZATION TO CONSTRUCT / OPERATION PERMIT / EXISTING SYSTEM INSPECTION

PERMIT# 111221 PIN# ~~4706-33-3364.16~~ 4706-43-1782 DATE 3/10/03

OWNER OR CONTRACTOR Jimmy Goss PHONE: Business (704) 791-3142 Home

ADDRESS P.O Box 142 Landis, N.C. 28088

LOCATION Hwy 70 W @ Robertson Rd @ Ridge Runner Dr

SUBDIVISION Ridgewest Est BLOCK / SECTION #2 LOT 16 LOT AREA .78 Ac. SITE CLASS. P5 DESIGN FLOW 360 L.T.A.R. .30

Septic Tank: 1,000 Gallons; STB 1012 Date 9-21-02
Pump Tank: 1,000 Gallons; PT 17 Date 1-3-03
Pump Make: Gould's Model WE05IIH Serial No. C0337154
Nitrification Field: No Fields 1 Square Feet Equiv. 1500 Linear Feet 300'
No Lines 5@60' Trench Width 36" Max Trench Bottom Depth 36" Gravel Depth NA

☒ New System ☐ Repair System Type: I, II, (III) IV, V, VI
System Description: Pump 25% Reduction
Repair System Description: Pump, Low Pressure Pipe
Maintenance Agreement Required: ☐ Yes ☒ No

☒ House/Mod. Home No. Bedrooms 3
☐ Mobile Home No. Bathrooms 2½
☐ Business No. Employees
☐ Other


☐ Slab ☒ Crawl Space ☐ Basement w/plumbing ☐ Basement wo/plumbing

Water Supply: ☐ Individual ☒ Public ☐ Community


Comments:/Conditions: (1) Install Lines on Contour (2) See Attachments "A" "B" as part of permit. (3) Call Health dept for pump sizing
H.P. Approval to move Driveway + Pressure Manifold

Comments:/Conditions: - EZ Flow - 300Ft installed
- Tuff-Tite Filter + S.T. Marker Installed

INITIAL SITE SKETCH 1" = 50'

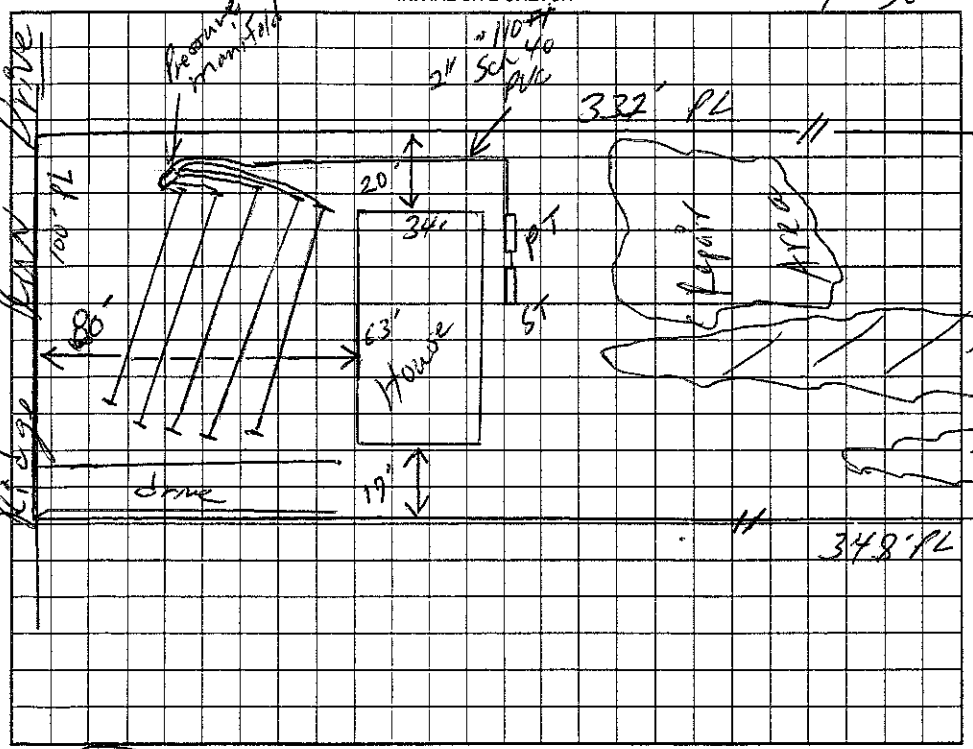

AS BUILT SKETCH

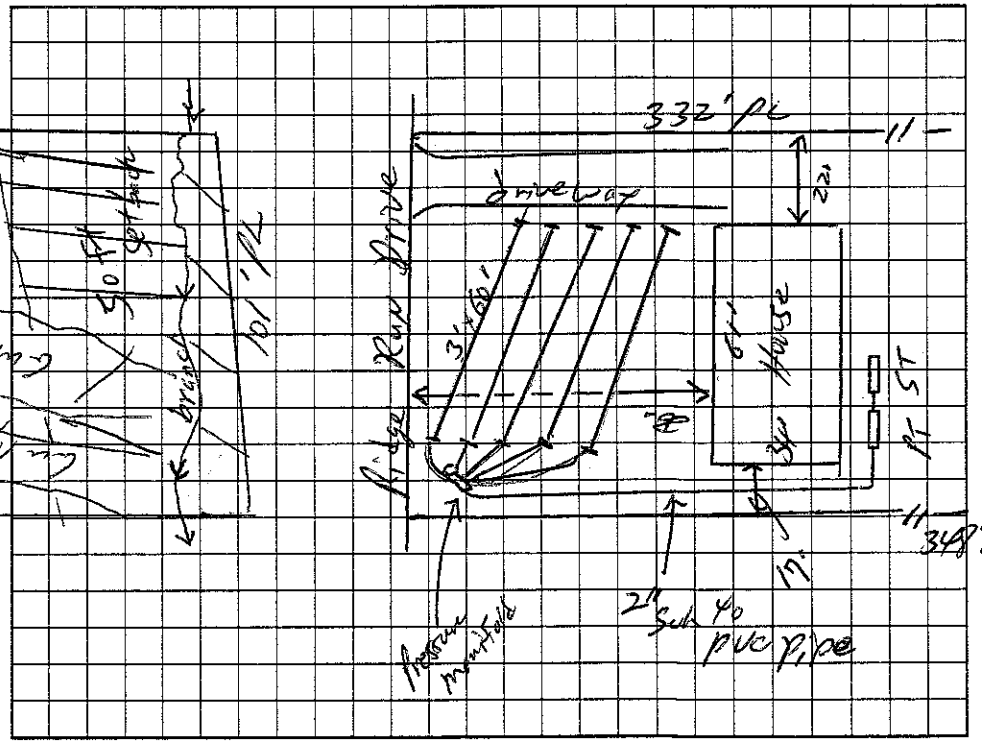

Permit can be suspended or revoked if any false information is supplied toward securing the permit/any unauthorized changes are made to the site/any unauthorized changes are made in the installation of the system. Improvement Permit with plat valid without expiration. Improvement Permit with site plan valid for sixty months. Authorization to Construct is valid for a period equal to that of Improvement Permit – not to exceed sixty months.

Signed: [signature] date 3/10/03 Installed by: Tommy Frye

Improvement Permit by: William O. Johnson date 3/10/03 Operation Permit by: William O. Johnson date 5/15/03

Authorization to Construct by: William O. Johnson date 3/10/03 Existing System Inspection by: date

HEALTH DEPT. COPY: WHITE OWNER COPY (FINAL): YELLOW OWNER COPY (INITIAL): PINK