IREDELL COUNTY HEALTH DEPARTMENT - *ENVIRONMENTAL HEALTH* ☒ STATESVILLE OFFICE 704-878-5305 ☐ MOORESVILLE OFFICE 704-664-5281

IMPROVEMENT PERMIT / AUTHORIZATION TO CONSTRUCT / OPERATION PERMIT / EXISTING SYSTEM INSPECTION

PERMIT #: 165062 PIN #: 4706-43-5950 DATE: 3-14-11

OWNER: Rovira's Construction APPLICANT: Clayton Homes PHONE: Home/Cell # 704 941-5307 Business #

SITE ADDRESS: 135 Ridge Run OWNER / APPLICANT ADDRESS: 253 West Statesville Mooresville, NC

SITE DIRECTIONS: Hwy 98 West TL Robertson TL Ridge Run

SUBDIVISION: Ridgewest Est II BLOCK / SECTION: LOT #: 12 LOT AREA: .633 Ac DESIGN FLOW: 360 L.T.A.R.: .25

Septic Tank: 1000 Gallons: STB 760 Date 6-10-70
Pump Tank: Gallons: P T Date
Pump Make: Model Serial #
No. Nitrification Fields: 1 No. Lines: 5 Linear Feet: 360
Trench Width: 36" Max. Trench Bottom Depth: 36" Gravel Depth: n/a

☒ New System ☐ Repair ☐ Expansion System Type I II (III) IV V VI
System Description: 25% Reduction Gravity
Repair System Description: 25% Reduction
Maintenance Agreement Required ☐ YES ☒ NO
☒ GRAVITY ☐ PRESSURE


☒ Residence No. Bedrooms: 3
☐ Business No. Persons:
☐ Other No. Employees:
☐ Slab ☐ Crawl Space
☒ Basement w/plumbing ☐ Basement w/o plumbing

Water Supply: ☒ Private ☐ Public ☐ Community

Comments / Conditions

Red Filler

INITIAL SITE SKETCH

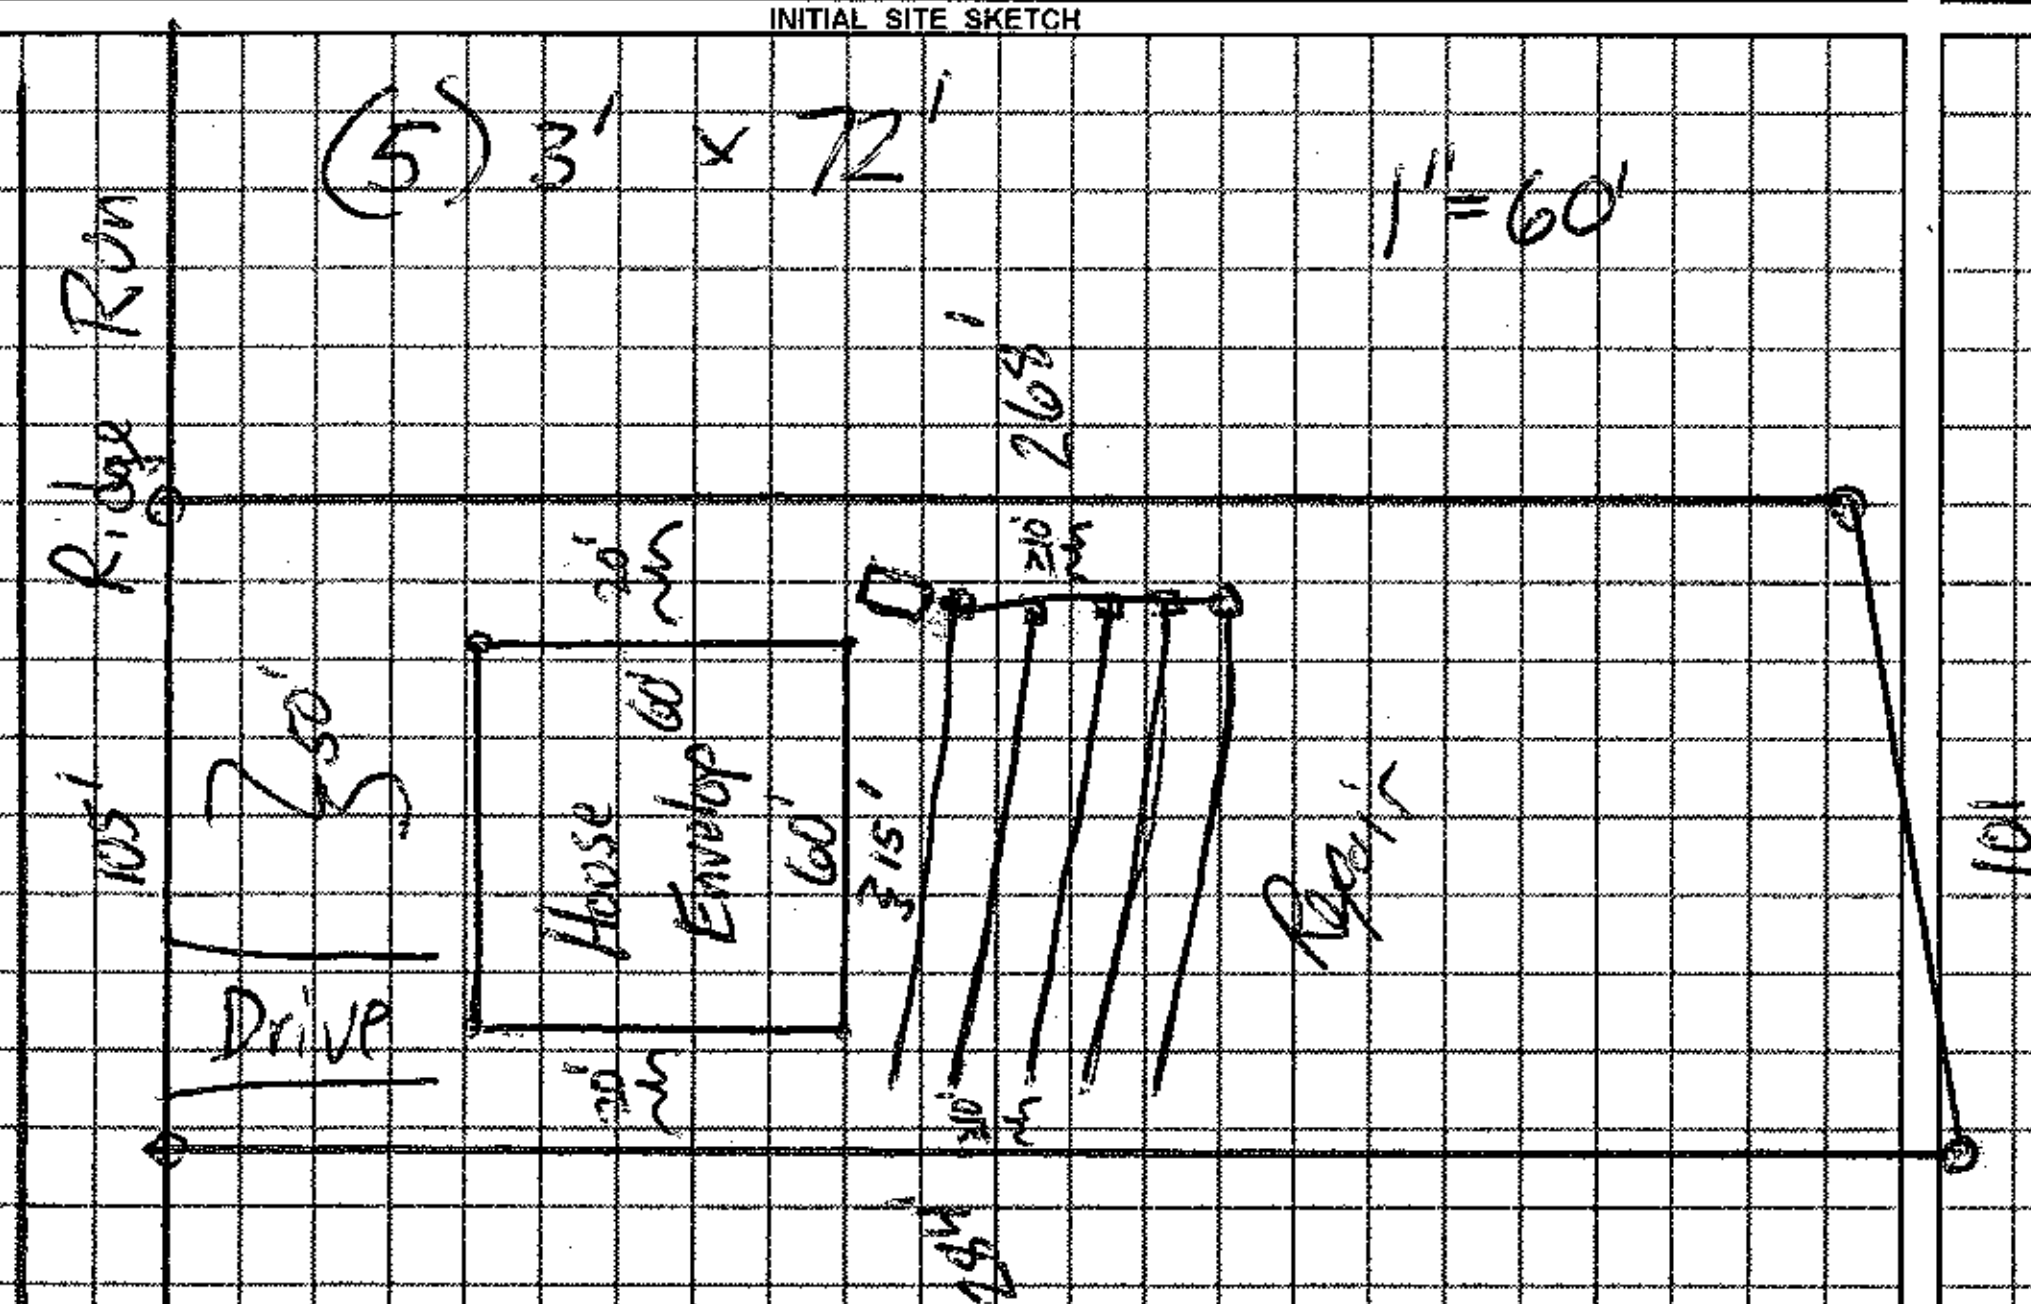

AS BUILT SKETCH

Permit can be suspended or revoked if any false information is supplied toward securing the permit / any unauthorized changes are made to the site / any unauthorized changes are made in the installation of the system.

☐ ***IMPROVEMENT PERMIT*** *with plat valid without expiration.* ☒ ***IMPROVEMENT PERMIT*** *with ~~plat valid without expiration~~.* site plan valid 60 mo. ☒ ***AUTHORIZATION TO CONSTRUCT*** valid for period equal to IMPROVEMENT PERMIT--not to exceed 60 mo.

Owner / Applicant Signature: [signature] Date 3-14-11 Installed by: Gunter Grading

IMPROVEMENT PERMIT by: [signature] **REHS** Date 3-14-11 OPERATION PERMIT by: [signature] **REHS** Date 3-21-11

AUTHORIZATION TO CONSTRUCT by: [signature] **REHS** Date 3-14-11 Existing System Inspected by: **REHS** Date

YOU SHOULD CONTACT A LOCATOR SERVICE PRIOR TO ANY EXCAVATION

White Copy – Environmental Health YELLOW COPY (Final) Owner / Applicant PINK COPY (Initial) Owner / Applicant