IREDELL COUNTY HEALTH DEPARTMENT

Statesville Office (704) 878-5305 Mooresville Office (704) 660-3625 PERMIT # 213818

IMPROVEMENT PERMIT / AUTHORIZATION TO CONSTRUCT / OPERATION PERMIT / EXISTING SYSTEM

PIN # 4706436934 ✓

APPLICANT: Greg Rovira APPLICANT ADDRESS: 131 Cajon Hideaway

SITE ADDRESS: 129 Ridge Run Drive PHONE: 704-585-9017 ALT. PHONE: N/A

SITE DIRECTIONS: Hwy 90 W TL Robertson Rd TL Ridge Run Dr. Property on Left


SUBDIVISION: Ridgewest Estates SECTION: N/A LOT # 11 LOT AREA: 0.575 DESIGN FLOW: 360gpd L.T.A.R.: 0.275

Septic Tank	1000 (gal)	STB	760-1000	Date	1-20	☑ New System ☐ Repair ☐ Expansion	System Type: I II (III) IV V VI	☑ Residence	No. Bedrooms 3
Pump Tank	(gal)	PT		Date		System Description:	25% Reduction	☐ Business	No. Persons 6
Pump Make		Model		Serial #		Repair System Description:	50% Reduction	☐ Other	No. Employees
# Nitrification Fields	1	# Lines	5	Linear Ft:	328	Maintenance Agreement Required:	☐ YES ☑ NO	☐ Slab	☐ Crawl Space
Trench Width	36"	Max. Trench Bottom Depth	30"	Gravel Depth	N/A	☑ GRAVITY	☐ PRESSURE	☑ Basement w/plumbing	☐ Basement w/o plumbing


Water Supply: ☐ Private ☑ Public ☐ Community

Comments / Conditions: Install a 25% Reduction system on contour with serial distribution.

INITIAL SITE SKETCH

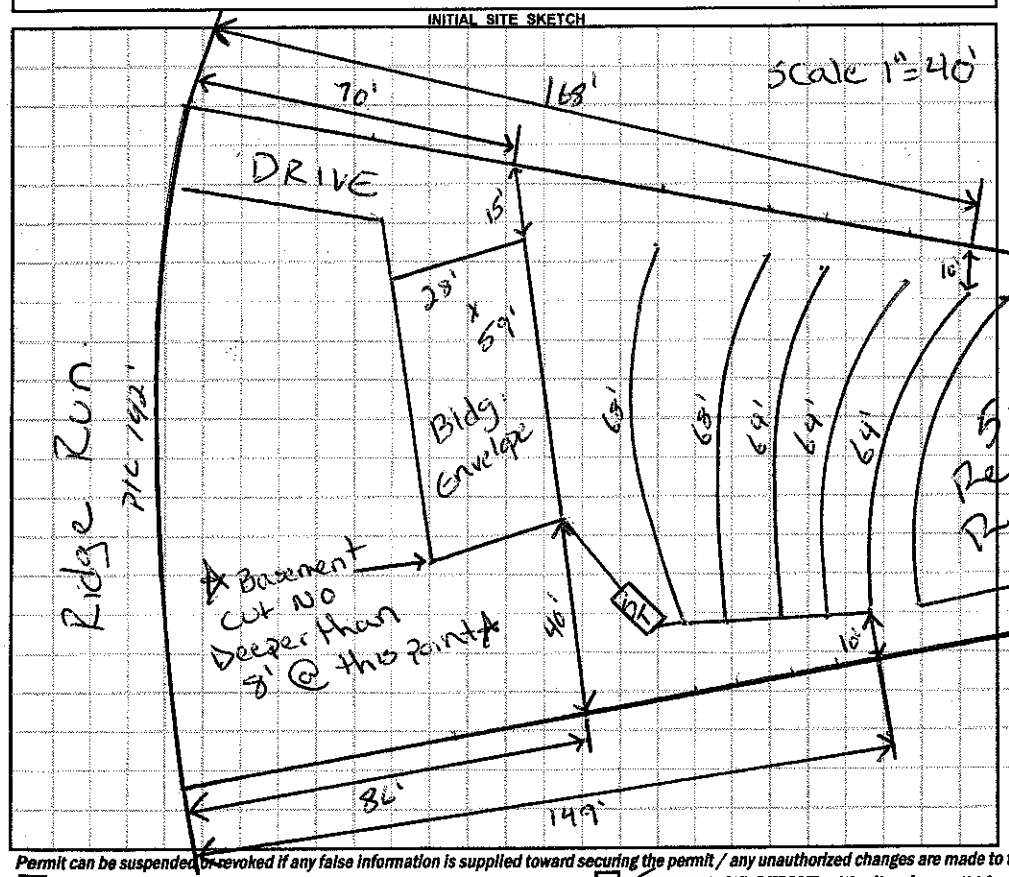

AS BUILT SKETCH

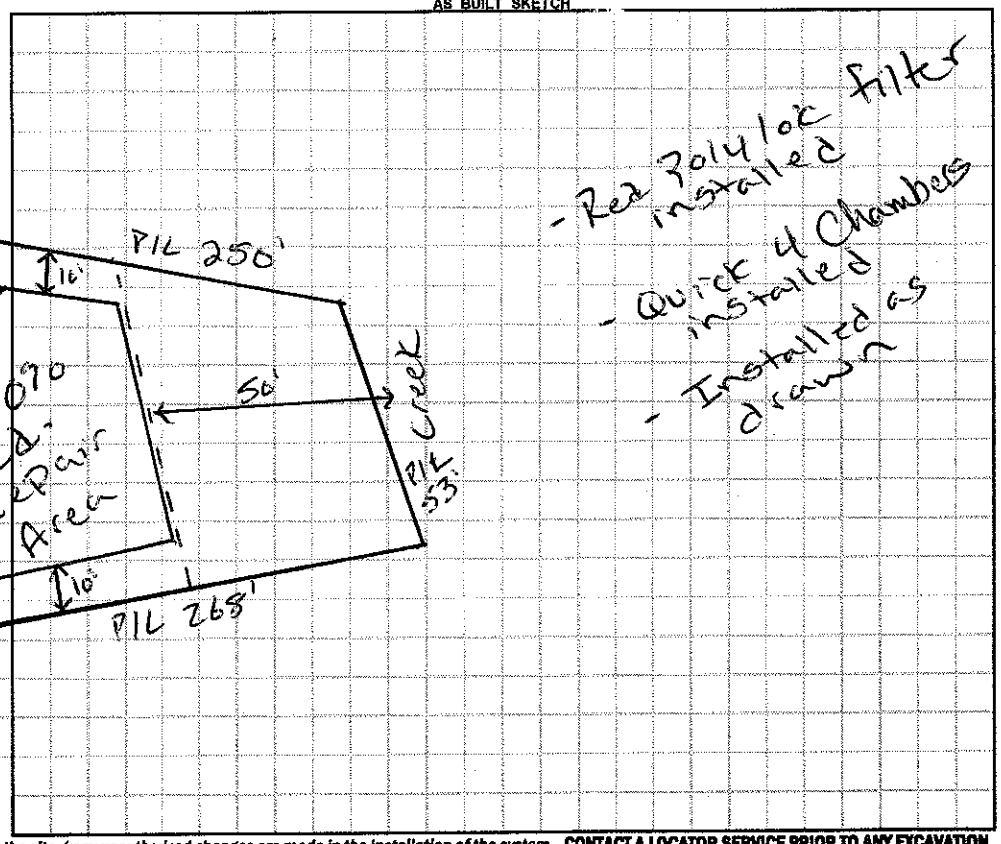

Permit can be suspended or revoked if any false information is supplied toward securing the permit / any unauthorized changes are made to the site / any unauthorized changes are made in the installation of the system. **CONTACT A LOCATOR SERVICE PRIOR TO ANY EXCAVATION**

☐ **IMPROVEMENT PERMIT** *with plat valid without expiration.* ☑ **IMPROVEMENT PERMIT** *with site plan valid for 60 mos.* ☑ **AUTHORIZATION TO CONSTRUCT** *valid for period equal to IMPROVEMENT PERMIT--not to exceed 60 mo.*

Owner / Applicant Signature: Greg Rovira Date: 10-20-15 Installed by: Gunter Grading

IMPROVEMENT PERMIT by: Justin Henderson Date: 10-20-15 OPERATION PERMIT by: Justin Henderson Date: 5-9-16

AUTHORIZATION TO CONSTRUCT by: Justin Henderson Date: 10-20-15 Existing System Inspected by: Date:

Health Dept. Copy - WHITE Applicant (Final Approval) - YELLOW Applicant (Conditional Approval) - PINK