16 Am J Rod Const

This Voids orginal Permit DATED 1-28-2000

IREDELL COUNTY HEALTH DEPARTMENT

STATESVILLE 704-878-5305 MOORESVILLE 704-664-5281

IMPROVEMENT PERMIT / AUTHORIZATION TO CONSTRUCT / OPERATION PERMIT / EXISTING SYSTEM INSPECTION

PERMIT# 87237 PIN# 4706337693 DATE April 13 2000

OWNER OR CONTRACTOR David Black PHONE: Business 336 345 3169 Home

ADDRESS

LOCATION Hwy 90 West ② Robertson ⑧ Ridge Run Lot on Right

SUBDIVISION Ridgewest BLOCK / SECTION LOT 5 LOT AREA ± 54 Ac SITE CLASS PS DESIGN FLOW 360 L.T.A.R. ± 3

Septic Tank: 1000 Gallons: STB Date

Pump Tank: Gallons; PT Date

Pump Make: Model Serial No.

Nitrification Field: No Fields 1 Square Feet 1200 Linear Feet 300

No Lines 4 Trench Width 36" Max Trench Bottom Depth 36" Gravel Depth N/A

☒ New System ☐ Repair System Type: I, II, III, IV, V, VI

System Description: 25% Reduction GRAVITY

Repair System Description: 25 - 50% Reduction GRAVITY

Maintenance Agreement Required: ☐ Yes ☒ No

☒ House/Mod. Home ☐ Mobile Home ☐ Business ☐ Other


No. Bedrooms 3 No. Bathrooms 2 No. Employees

☐ Slab ☒ Crawl Space ☐ Basement w/plumbing ☐ Basement wo/plumbing


Water Supply: ☐ Individual ☒ Public ☐ Community

Comments/Conditions: INSTALL on CONTOUR : Locate back Prop Line To INSURE SETBACK
MAY USE DISTRIBUTION box W/Speed levels for equal distribution
56 CHAMBERS OR 30 HDS5 SECTIONS

INITIAL SITE SKETCH

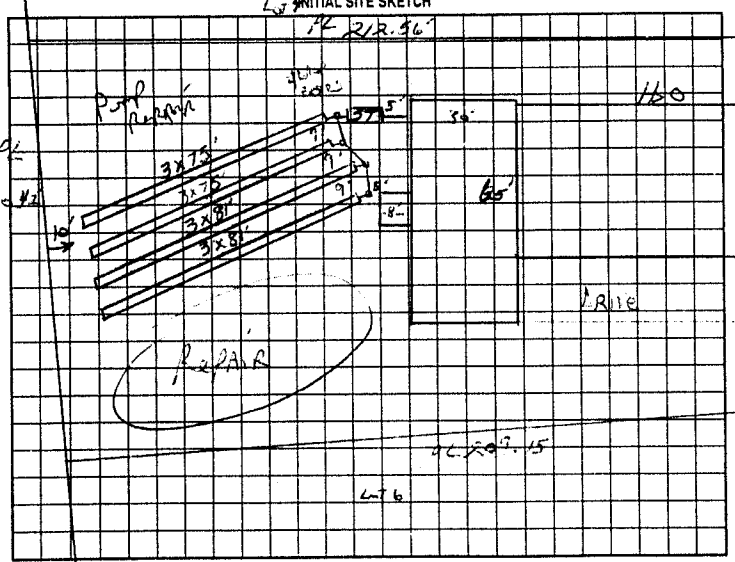

AS BUILT SKETCH

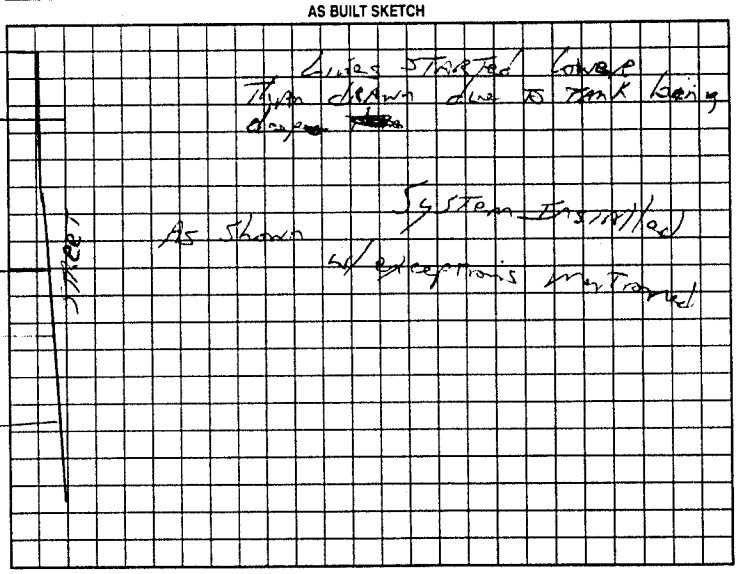

Permit can be suspended or revoked if any false information is supplied toward securing the permit/any unauthorized changes are made to the site/any unauthorized changes are made in the installation of the system. Improvement Permit with plat valid without expiration. Improvement Permit with site plan valid for sixty months. Authorization to Construct is valid for a period equal to that of Improvement Permit – not to exceed sixty months.

Signed: D Johnston date Installed by: J Rod Trucking

Improvement Permit by: J. Potter date 4/13/2000 Operation Permit by: J. Potter date July 27 2000

Authorization to Construct by: J. Potter date 4/13/2000 Existing System Inspection by: date

HEALTH DEPT. COPY: WHITE OWNER COPY (FINAL): YELLOW OWNER COPY (INITIAL): PINK