IREDELL COUNTY HEALTH DEPARTMENT - *ENVIRONMENTAL HEALTH* ☐ STATESVILLE OFFICE 704-878-5305 ☐ MOORESVILLE OFFICE 704-664-5281

IMPROVEMENT PERMIT / AUTHORIZATION TO CONSTRUCT / OPERATION PERMIT / EXISTING SYSTEM INSPECTION

PERMIT # REPAIR PIN # 4706-45-4244 DATE APRIL 19 2012

OWNER JERRY MORRISON APPLICANT: SAME PHONE: Home/Cell # 704-585-6094 Business # 704-657-3299

SITE ADDRESS 4549 TAYLORSVILLE HWY OWNER / APPLICANT ADDRESS SAME

SITE DIRECTIONS NC 90 WEST ON LEFT AT BOX # 4549, BACK OFF ROAD

SUBDIVISION BLOCK / SECTION LOT # LOT AREA DESIGN FLOW 480 L.T.A.R. 0.30 GPD/FT2

Septic Tank EXISTING Gallons: STB Date

Pump Tank Gallons: P T Date

Pump Make Model Serial #

No. Nitrification Fields: 1 No. Lines 2 Linear Feet 240

Trench Width 36" Max. Trench Bottom Depth 36" Gravel Depth N/A

☐ New System ☑ Repair ☐ Expansion System Type I II (III) IV V VI

System Description:

Repair System Description: 25% REDUCTION, GRAVITY

Maintenance Agreement Required ☐ YES ☑ NO

☑ GRAVITY ☐ PRESSURE

☑ Residence No. Bedrooms 4

☐ Business No. Persons

☐ Other No. Employees


☐ Slab ☑ Crawl Space

☐ Basement w/plumbing ☐ Basement w/o plumbing

Water Supply: ☐ Private ☑ Public ☐ Community

Comments / Conditions: INSTALL TWO (2) NEW DROP BOXES AS SHOWN, FEEDING TWO OLD LINES FIRST. INSTALL 25% REDUCTION DRAINLINES USING SERIAL DISTRIBUTION.

INITIAL SITE SKETCH

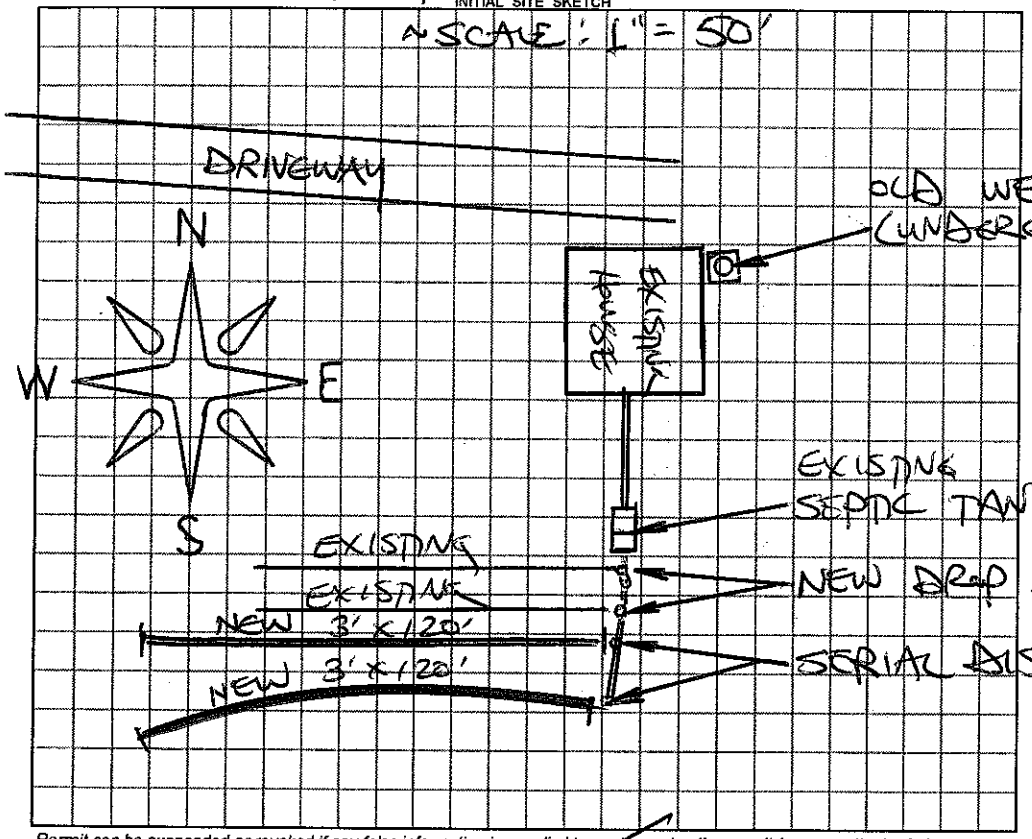

AS BUILT SKETCH

Permit can be suspended or revoked if any false information is supplied toward securing the permit / any unauthorized changes are made to the site / any unauthorized changes are made in the installation of the system.

☐ ***IMPROVEMENT PERMIT*** with plat valid without expiration. ☑ ***IMPROVEMENT PERMIT*** with plat valid without expiration. ***site plan valid 60 mo.*** ☑ ***AUTHORIZATION TO CONSTRUCT*** valid for period equal to IMPROVEMENT PERMIT–not to exceed 60 mo.

Owner / Applicant Signature: Jerry R. Morrison Date 4-19-2012 Installed by: Bill Bell James Lentz

IMPROVEMENT PERMIT by: STEVE HERRICK REHS Date 4-19-2012 OPERATION PERMIT by: James Lentz REHS Date 4-24-12

AUTHORIZATION TO CONSTRUCT by: STEVE HERRICK REHS Date 4-19-2012 Existing System Inspected by: REHS Date

YOU SHOULD CONTACT A LOCATOR SERVICE PRIOR TO ANY EXCAVATION

White Copy – Environmental Health YELLOW COPY (Final) Owner / Applicant PINK COPY (Initial) Owner / Applicant