4:30

IREDELL COUNTY HEALTH DEPARTMENT

STATESVILLE 704-878-5305 MOORESVILLE 704-664-5281

IMPROVEMENT PERMIT / CERTIFICATE OF COMPLETION / OPERATION PERMIT / EXISTING SYSTEM INSPECTION

PROPERTY DESCRIPTION NO. [redacted] 67285 DATE 6-23-97 TAX MAP NO. 4706 4770 30 Watershed: ☐ Yes ☒ No

OWNER OR CONTRACTOR Wanda Rector PHONE: Business _____ Home 704 871 1059

ADDRESS Rt 1 Box 577-F Hiddenite, N.C.

LOCATION Taylorsville Hwy TL Hank Feimster [redacted] Dr. on left

SUBDIVISION A.L. Feimster BLOCK / SECTION _____ LOT 12 LOT AREA 3.15 acres SITE CLASS PS DESIGN FLOW 360 L.T.A.R. .3

Septic Tank: 1000 Gallons; STB 1017 Date 6-15-99

Pump Tank: _____ Gallons; PT _____ Date _____

Pump Make: _____ Model _____ Serial No. _____

Nitrification Field: No Fields 1 Square Feet 1200 Linear Feet 400

No Lines 4 Trench Width 36" Max Trench Bottom Depth 36" Gravel Depth 12"

☒ New System ☐ Repair System Type: I ☒ II, III, IV, V, VI

System Description: Conv. Gravity

Repair System Description: " "

Maintenance Agreement Required: ☐ Yes ☒ No

☒ House/Mod. Home No. Bedrooms 3

☐ Mobile Home No. Bathrooms 2

☐ Business No. Employees _____

☐ Other _____

☐ Slab ☒ Crawl Space ☐ Basement w/plumbing ☐ Basement wo/plumbing


Water Supply: ☐ Individual ☐ Community ☒ Public

Alexander Lester


Comments: Hwy 90

Comments:

INITIAL SITE SKETCH

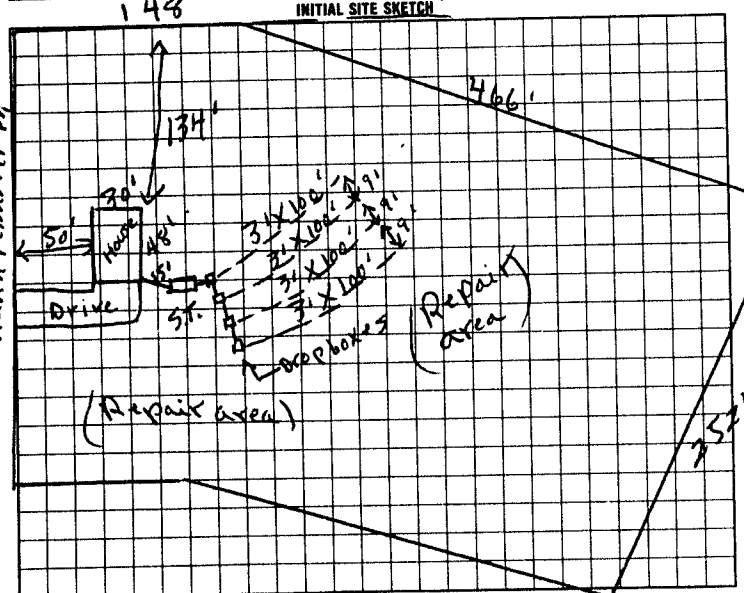

AS BUILT SKETCH

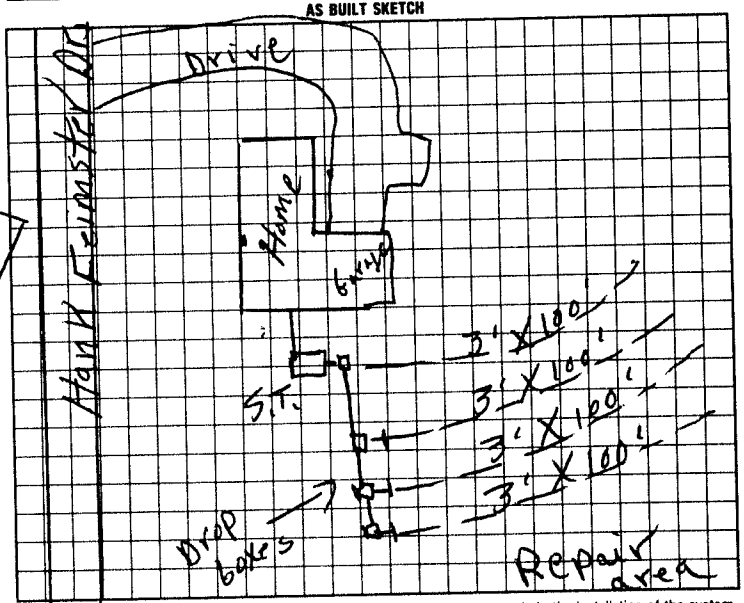

I understand that this permit can be suspended or revoked if any false information is supplied toward securing the permit/any unauthorized changes are made to the site/any unauthorized changes are made in the installation of the system. Improvement Permit is valid for 60 months from date of issuance.

Signed: X Wanda L. Rector

Improvement Permit by: P.C. Moore date 6-23-97

Authorization by: P.C. Moore date 6-23-97

HEALTH DEPT. COPY: WHITE INSPECTION COPY (FINAL): GREEN OWNER COPY (FINAL): YELLOW

Installed by: Dale Fox

Certificate of Completion by: _____ date _____

Operation Permit by: P.C. Moore date 8-18-99

INSPECTION COPY (INITIAL): PINK OWNER COPY (INITIAL): GOLD

to const. Authorization to const EXPIRES 60 mos from issue