4:30

IREDELL COUNTY HEALTH DEPARTMENT

STATESVILLE 704-878-5305 MOORESVILLE 704-664-5281

IMPROVEMENT PERMIT / CERTIFICATE OF COMPLETION / OPERATION PERMIT / EXISTING SYSTEM INSPECTION

PROPERTY DESCRIPTION NO. 25749 DATE 1-2-97 TAX MAP NO. 9K-A-26 Watershed: ☐ Yes ☒ No

OWNER OR CONTRACTOR KAREN & JOE REDMOND PHONE: Business Home 871-1198

ADDRESS 121 BOWMAN ROAD, STATESVILLE NC 28677

LOCATION NC 90 W, TR ANTIOCH ROAD, CROSS RAILROAD TRACKS 1ST DRIVE ON LEFT

SUBDIVISION BLOCK / SECTION LOT LOT AREA 2.84 ACRES SITE CLASS. PS DESIGN FLOW 360 L.T.A.R. 0.33 GPD/FT²

Septic Tank: 1000 Gallons; STB 1012 Date 1-10-97

Pump Tank: Gallons; PT Date

Pump Make: Model Serial No.

Nitrification Field: No Fields 1 Square Feet 1080 Linear Feet 360

No Lines FOUR Trench Width 36" Max Trench Bottom Depth 36"

☑ New System ☐ Repair System Type: I, II, III, IV, V, VI

System Description: CONVENTIONAL → GRAVITY

Repair System Description: CONV. GRAVITY

Maintenance Agreement Required: ☐ Yes ☐ No

Gravel Depth 12" ☐ Slab ☑ Crawl Space ☐ Basement w/plumbing ☐ Basement wo/plumbing

☑ House/Mod. Home No. Bedrooms 3

☐ Mobile Home No. Bathrooms 2

☐ Business No. Employees


☐ Other

Water Supply: ☐ Individual ☐ Community ☒ Public


Comments: ① INSTALL FOUR LINES AS SHOWN ON CONTOUR NO DEEPER THAN 36", 9' ON CENTERS ② USE TWO DIST. BOXES FOR SERIAL DISTRIBUTION.

Comments:

INITIAL SITE SKETCH SCALE: 1" = 60'

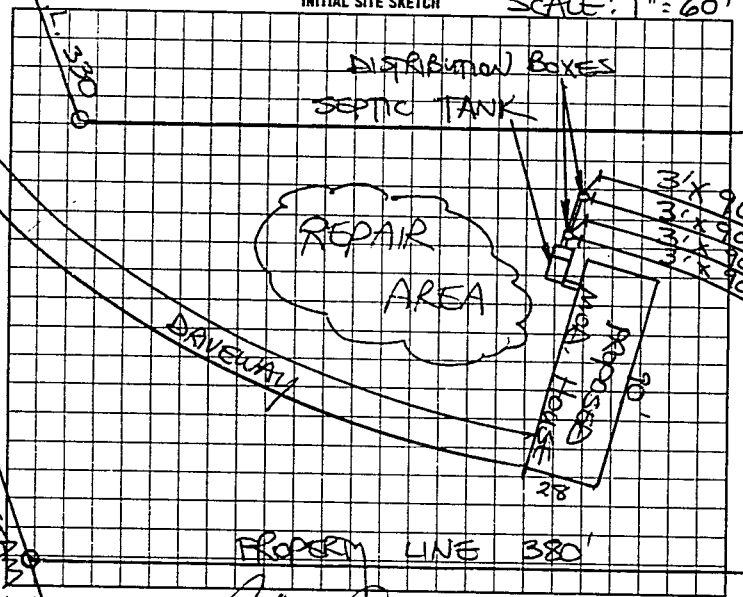

AS BUILT SKETCH

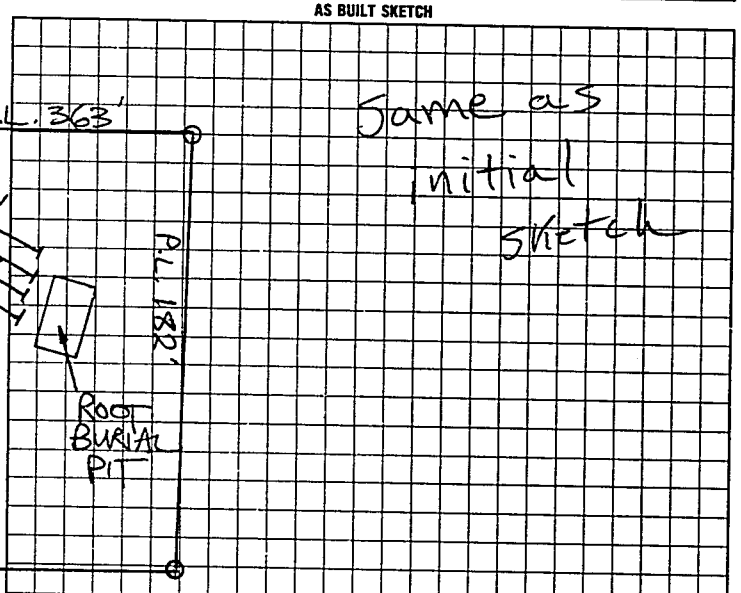

I understand that this permit can be suspended or revoked if any false information is supplied toward securing the permit/any unauthorized changes are made to the site/any unauthorized changes are made in the installation of the system. Improvement Permit is valid for 60 months from date of issuance. AUTH. TO CONST. IS VALID FOR 60 MONTHS FROM DATE OF ISSUANCE.

Signed: X

Improvement Permit by: STEVE HEDRICK date 1-2-97

AUTH. TO CONST. Existing System Inspection by: STEVE HEDRICK date 1-2-97

Installed by: Tommy Frye

~~Certificate of Completion by:~~ date

Operation Permit by: J.C. Moore date 3-25-97

HEALTH DEPT COPY WHITE INSPECTION COPY (FINAL) GREEN OWNER COPY (FINAL) YELLOW INSPECTION COPY (INITIAL) PINK

8 5 2 6 0 0