IREDELL COUNTY HEALTH DEPARTMENT

STATESVILLE 704-878-5305 MOORESVILLE 704-664-5281

IMPROVEMENT PERMIT / AUTHORIZATION TO CONSTRUCT / OPERATION PERMIT / EXISTING SYSTEM INSPECTION

PERMIT# 86214 PIN# 4706 50 1622 DATE Nov 23 99

OWNER OR CONTRACTOR Reggie Sherrill PHONE: Business Home 873 0652

ADDRESS

LOCATION Hwy 90 W @ Wildhurst Follow To end home on Right

SUBDIVISION BLOCK / SECTION LOT LOT AREA SITE CLASS. P5 DESIGN FLOW 360 L.T.A.R. .3

Septic Tank: 1000 Existing Gallons; STB Date

Pump Tank: Gallons; PT Date

Pump Make: Model Serial No.

Nitrification Field: No Fields 1 Square Feet Linear Feet 400 TOTAL

No Lines 2@75 Trench Width 36" Max Trench Bottom Depth 36"

☐ New System ☐ Repair System Type: I ☒ III. IV. V. VI

System Description: Conv GRAVITY

Repair System Description: SAME

Maintenance Agreement Required: ☐ Yes ☒ No

Gravel Depth 12"

☐ Slab ☒ Crawl Space ☐ Basement w/plumbing ☐ Basement wo/plumbing

☐ House/Mod. Home No. Bedrooms 3

☒ Mobile Home No. Bathrooms 2

☐ Business No. Employees

☐ Other


Water Supply: ☒ Individual ☐ Public ☐ Community

well


Comments/Conditions: Inspect OUTLET of Septic TANK & Replace "T" if needed. Replace old D. Box & Solid pipe To existing Lines CALL 928 2030 IF ANY QUESTIONS

Comments/Conditions: Replaced outlet Tee & 1st D-Box IS NEEDED

INITIAL SITE SKETCH

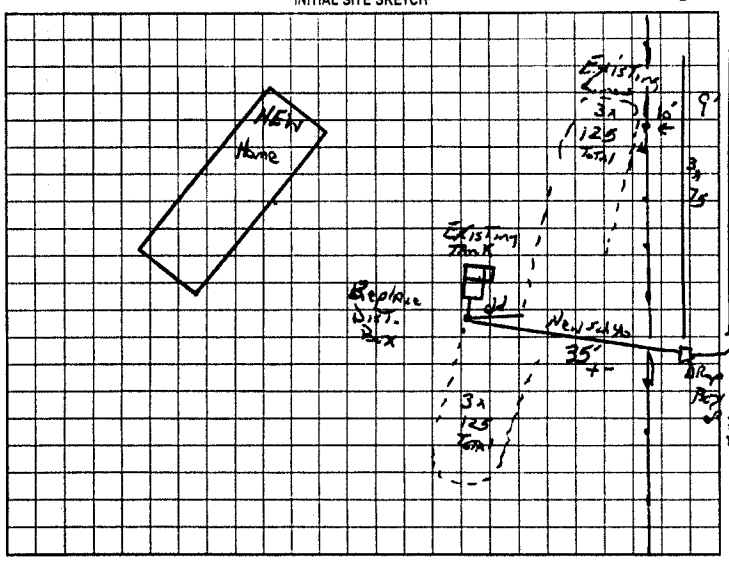

AS BUILT SKETCH

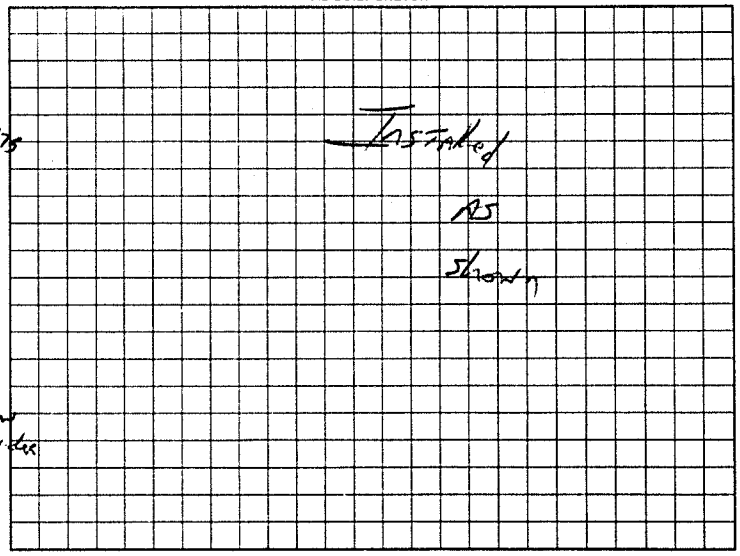

Permit can be suspended or revoked if any false information is supplied toward securing the permit/any unauthorized changes are made to the site/any unauthorized changes are made in the installation of the system. Improvement Permit with plat valid without expiration. Improvement Permit with site plan valid for sixty months. Authorization to Construct is valid for a period equal to that of Improvement Permit – not to exceed sixty months.

Signed: Kenny Madison 12-7-99 date

Improvement Permit by: Jc Potter date Nov 29 99

Authorization to Construct by: Jc Potter date Nov 29 99

Installed by: Kenny Madison

Operation Permit by: Jc Potter date Dec 7, 99

Existing System Inspection by: date

HEALTH DEPT. COPY: WHITE OWNER COPY (FINAL): YELLOW OWNER COPY (INITIAL): PINK