IREDELL COUNTY HEALTH DEPARTMENT

STATESVILLE 704-878-5305 MOORESVILLE 704-664-5281

IMPROVEMENT PERMIT / AUTHORIZATION TO CONSTRUCT / OPERATION PERMIT / EXISTING SYSTEM INSPECTION

PERMIT# 87235 PIN# 4706 512312 DATE 10/25/00

OWNER OR CONTRACTOR Jeffery Moore PHONE: Business Home 528 3802

ADDRESS 178 Jeremy Ln Statesville NC 28677

LOCATION Hwy 90, L Wildhurst, R Marvue, on Rt.

SUBDIVISION Mar-Vue BLOCK / SECTION LOT 23/24 LOT AREA 2.56 AC SITE CLASS PS DESIGN FLOW 480 L.T.A.R. 0.3

Septic Tank: 1000 Gallons; STB 1012 Date 6-16-01
Pump Tank: Gallons; PT Date
Pump Make: Model Serial No.
Nitrification Field: No Fields 1 Square Feet 1600 Linear Feet 534
No Lines 6 @ 90' Trench Width 36" Max Trench Bottom Depth 36" Gravel Depth 12"


☒ New System ☐ Repair System Type: (I) II III IV V VI
System Description: Gravity Conv.
Repair System Description: Gravity 25% Rd
Maintenance Agreement Required: ☐ Yes ☐ No

☒ House/Mod. Home No. Bedrooms 4
☐ Mobile Home No. Bathrooms 2
☐ Business No. Employees
☐ Other
☐ Slab ☒ Crawl Space ☒ Basement w/plumbing ☒ Basement wo/plumbing

Water Supply: ☐ Individual ☒ Public ☐ Community


Comments:/Conditions:

INITIAL SITE SKETCH

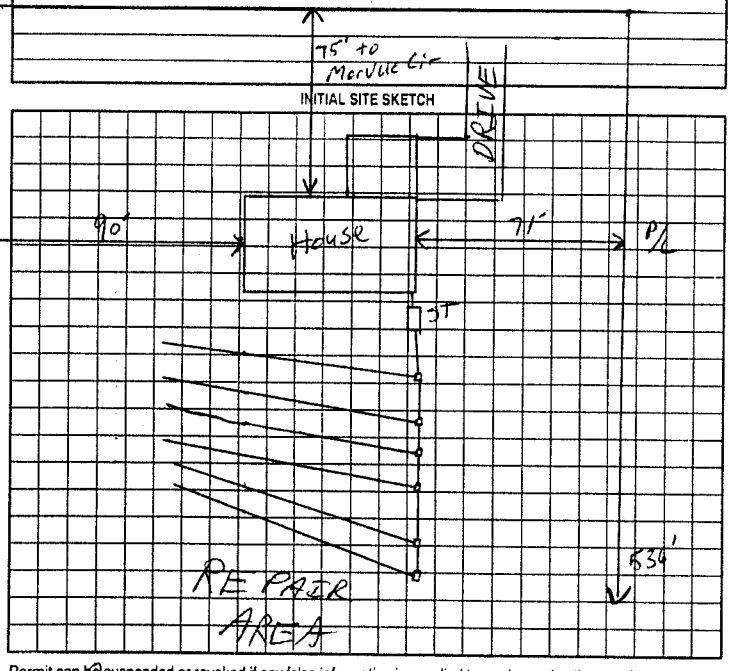

Comments /Conditions:
- Polylok filter Installed
- Septic Tank Marker Installed

AS BUILT SKETCH

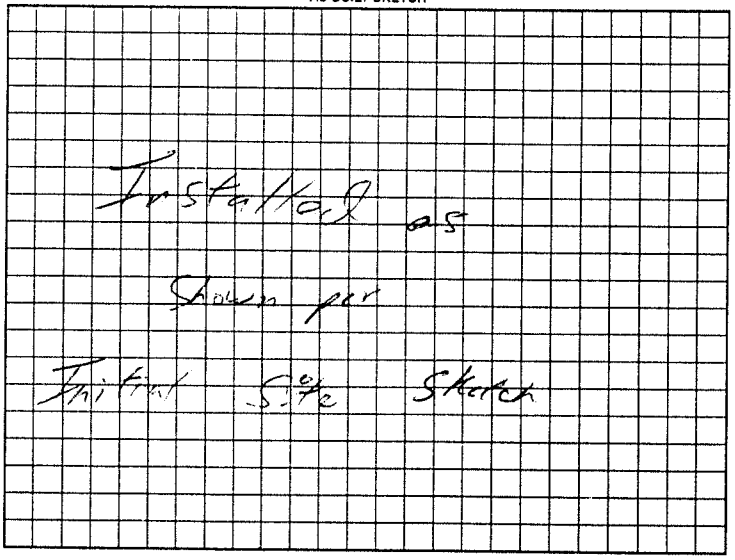

Permit can be suspended or revoked if any false information is supplied toward securing the permit/any unauthorized changes are made to the site/any unauthorized changes are made in the installation of the system. Improvement Permit with plat valid without expiration. Improvement Permit with site plan valid for sixty months. Authorization to Construct is valid for a period equal to that of Improvement Permit – not to exceed sixty months.

Signed: Crystal Moore date 10-26-00 Installed by: Steve Jordan

Improvement Permit by: RSI date 10/25/00 Operation Permit by: William A Johnson RSI date 8/6/01

Authorization to Construct by: RSI date 10/25/00 Existing System Inspection by: date

HEALTH DEPT. COPY: WHITE OWNER COPY (FINAL): YELLOW OWNER COPY (INITIAL): PINK