IREDELL COUNTY HEALTH DEPARTMENT

STATESVILLE 704-878-5305 MOORESVILLE 704-664-5281

IMPROVEMENT PERMIT / CERTIFICATE OF COMPLETION / OPERATION PERMIT / EXISTING SYSTEM INSPECTION

PROPERTY DESCRIPTION NO. 25614 DATE 12-4-96 TAX MAP NO. 9F-A-39 Watershed: ☐ Yes ☐ No

OWNER OR CONTRACTOR Juanita Ellis PHONE: Business _____ Home 873 3298

ADDRESS 105 Marcel Rd

LOCATION 90W TL Coell Rd TR Marcel 200' Rt

SUBDIVISION _____ BLOCK / SECTION _____ LOT _____ LOT AREA 4acres SITE CLASS. PS DESIGN FLOW 360 L.T.A.R. .3

Septic Tank: 1000 Gallons; STB 1007 Date 5-1-97
Pump Tank: _____ Gallons; PT _____ Date _____
Pump Make: _____ Model _____ Serial No. _____
Nitrification Field: No Fields 3 Square Feet 1200 Linear Feet 400
No Lines 4 Trench Width 36" Max Trench Bottom Depth 36" Gravel Depth 12"

☑ New System ☐ Repair System Type: ☐ I ☐ II ☑ III, IV, V, VI
System Description: Conv. Gravity
Repair System Description: Gravity chambers
Maintenance Agreement Required: ☐ Yes ☑ No
☐ Slab ☑ Crawl Space ☐ Basement w/plumbing ☐ Basement wo/plumbing


☐ House/Mod. Home ☑ Mobile Home ☐ Business ☐ Other
No. Bedrooms 3 No. Bathrooms 2 No. Employees ____

Water Supply: ☐ Individual ☐ Community ☑ Public


Comments:

Comments:
6-10 - Check call but remains 125ft line

INITIAL SITE SKETCH

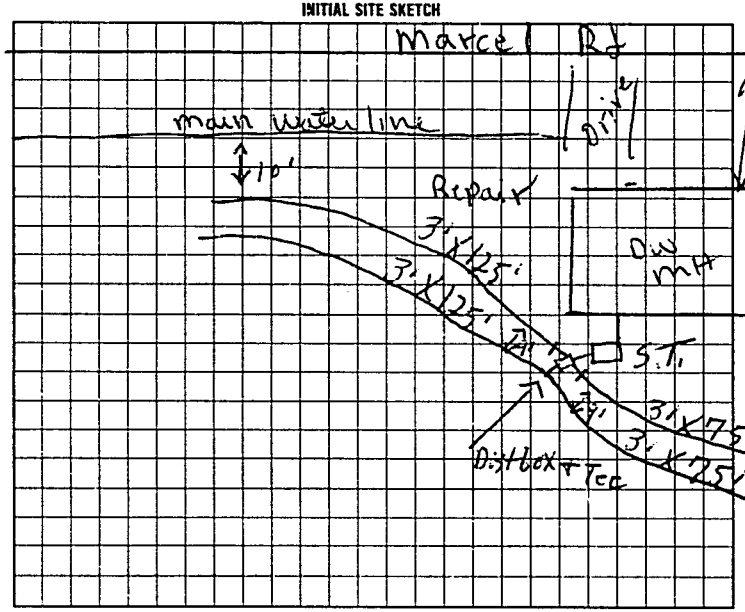

AS BUILT SKETCH

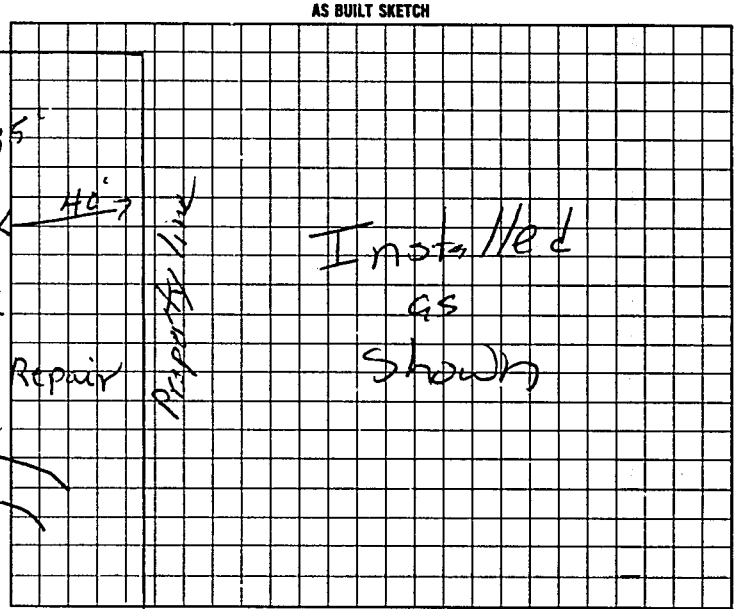

I understand that this permit can be suspended or revoked if any false information is supplied toward securing the permit/any unauthorized changes are made to the site/any unauthorized changes are made in the installation of the system. Improvement Permit is valid for 60 months from date of issuance.

Signed: [signature]

Improvement Permit by: R.C. Moore date 12-4-96

Existing System Inspection by: Authorization R.C. Moore date 12-4-96

Installed by: Benny Symon / Donald Lackey

Certificate of Completion by: _____ date _____

Operation Permit by: Mark Ogles date 6-12-97

HEALTH DEPT. COPY: WHITE INSPECTION COPY (FINAL): GREEN OWNER COPY (FINAL): YELLOW

INSPECTION COPY (INITIAL): PINK OWNER COPY (INITIAL): GOLD

+1 cond. Authorization to Const. expires 60 mos. from issue

81S000