IREDELL COUNTY HEALTH DEPARTMENT

STATESVILLE 704-878-5305 MOORESVILLE 704-664-5281

IMPROVEMENT PERMIT / AUTHORIZATION TO CONSTRUCT / OPERATION PERMIT / EXISTING SYSTEM INSPECTION

PERMIT# 120780 PIN# 4706-52-0866 DATE 5-17-04

OWNER OR CONTRACTOR Raymond Cole PHONE: Business Home 704-873-1873

ADDRESS 248 Cedar Ridge Loop Statesville NC 28625

LOCATION Hwy 90 TL Odell Rd TR Marcel Rd Property in front of 185 Marcel Rd (Address for this home is 108 Marcel Rd)

SUBDIVISION BLOCK / SECTION LOT LOT AREA ~~1.5AC~~ 2.0 SITE CLASS. PS DESIGN FLOW 360 L.T.A.R. Ex.

Septic Tank: Ex. Gallons; STB Date

Pump Tank: Gallons; PT Date

Pump Make: Model Serial No.

Nitrification Field: No Fields 1 Square Feet Linear Feet Ex.

No Lines Ex. Trench Width Max Trench Bottom Depth Gravel Depth

☐ New System ☐ Repair System Type: I (II) III, IV, V, VI

System Description: Con. Gravity

Repair System Description:

Maintenance Agreement Required: ☐ Yes ☑ No

☐ House/Mod. Home No. Bedrooms 3

☑ Mobile Home No. Bathrooms 2

☐ Business No. Employees

☐ Other


☐ Slab ☐ Crawl Space ☐ Basement w/plumbing ☐ Basement wo/plumbing

Water Supply:
☐ Individual
☑ Public
☐ Community


Comments:/Conditions:

Comments:/Conditions: (1) System functioning properly at time of inspection (2) Permission to connect to proposed structure (3) New structure shall not increase number of bedrooms on system (4) This is a visual inspection only. There is no guarantee problems will not arise in future.

INITIAL SITE SKETCH

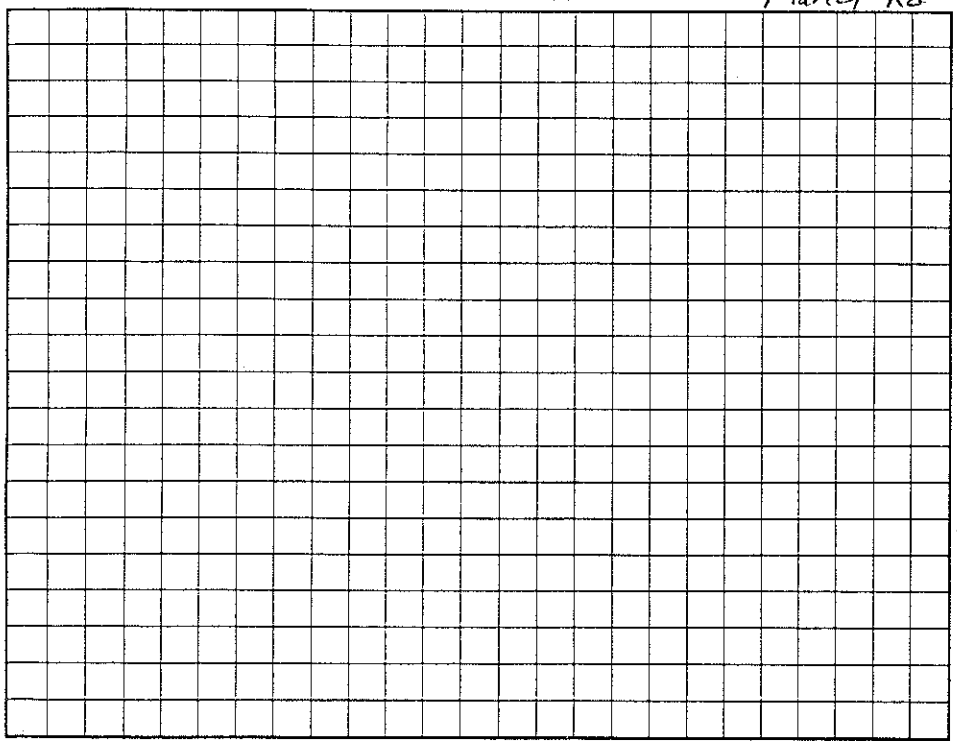

AS BUILT SKETCH

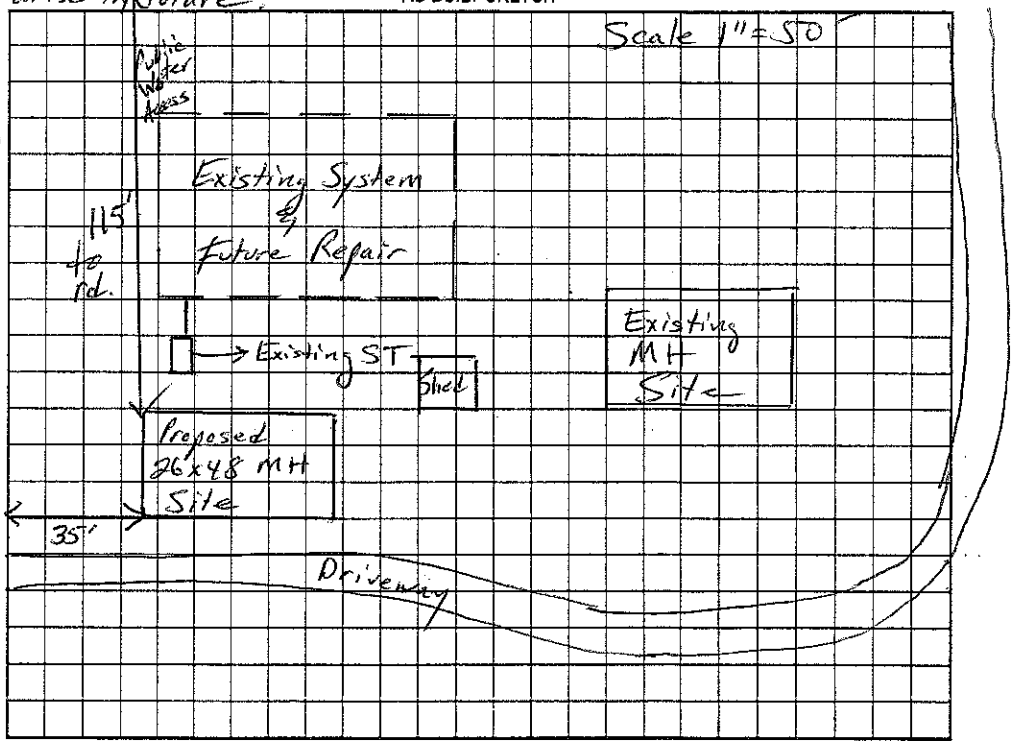

Permit can be suspended or revoked if any false information is supplied toward securing the permit/any unauthorized changes are made to the site/any unauthorized changes are made in the installation of the system. Improvement Permit with plat valid without expiration. Improvement Permit with site plan valid for sixty months. Authorization to Construct is valid for a period equal to that of Improvement Permit – not to exceed sixty months.

Signed: Raymond M Cole date 5-17-04

Improvement Permit by: date

Authorization to Construct by: date

Installed by:

Operation Permit by: date

Existing System Inspection by: [signature] date 5-17-04

HEALTH DEPT. COPY: WHITE OWNER COPY (FINAL): YELLOW OWNER COPY (INITIAL): PINK