IREDELL COUNTY HEALTH DEPARTMENT

Statesville Office (704) 878-5305 Mooresville Office (704) 660-3625 PERMIT # 216627

IMPROVEMENT PERMIT / AUTHORIZATION TO CONSTRUCT / OPERATION PERMIT / EXISTING SYSTEM

PIN # 4706527866 77

APPLICANT: George Saffos APPLICANT ADDRESS: 104 Odell Rd.

SITE ADDRESS: 114 Odell Rd. PHONE: 704-873-9184 ALT. PHONE: 704-873-4626

SITE DIRECTIONS: Hwy 90W TL Odell Rd Property on Right

SUBDIVISION: N/A SECTION: N/A LOT # N/A LOT AREA: 0.51 DESIGN FLOW: 240 gpd L.T.A.R.: Existing

Septic Tank	Existing	(gal)	STB		Date	☐ New System	☐ Repair	☐ Expansion	System Type: I (II) III IV V VI	☑ Residence	No. Bedrooms	2	Water Supply		
Pump Tank		(gal)	PT		Date	System Description:	Existing			☐ Business	No. Persons	4	☐ Private		
Pump Make		Model			Serial #	Repair System Description:				☐ Other	No. Employees		☑ Public		
# Nitrification Fields	Ex	# Lines	Ex		Linear Ft: Ex	Maintenance Agreement Required:	☐ YES	☑ NO		☐ Slab	☑ Crawl Space		☐ Community		
Trench Width	Ex	Max. Trench Bottom Depth	Ex		Gravel Depth Ex		☑ GRAVITY	☐ PRESSURE		☐ Basement w/plumbing			☐ Basement w/o plumbing		


Comments / Conditions:

- Maintain a minimum of 5' between proposed addition + all components of septic tank system

INITIAL SITE SKETCH

1" = 60'

AS BUILT SKETCH

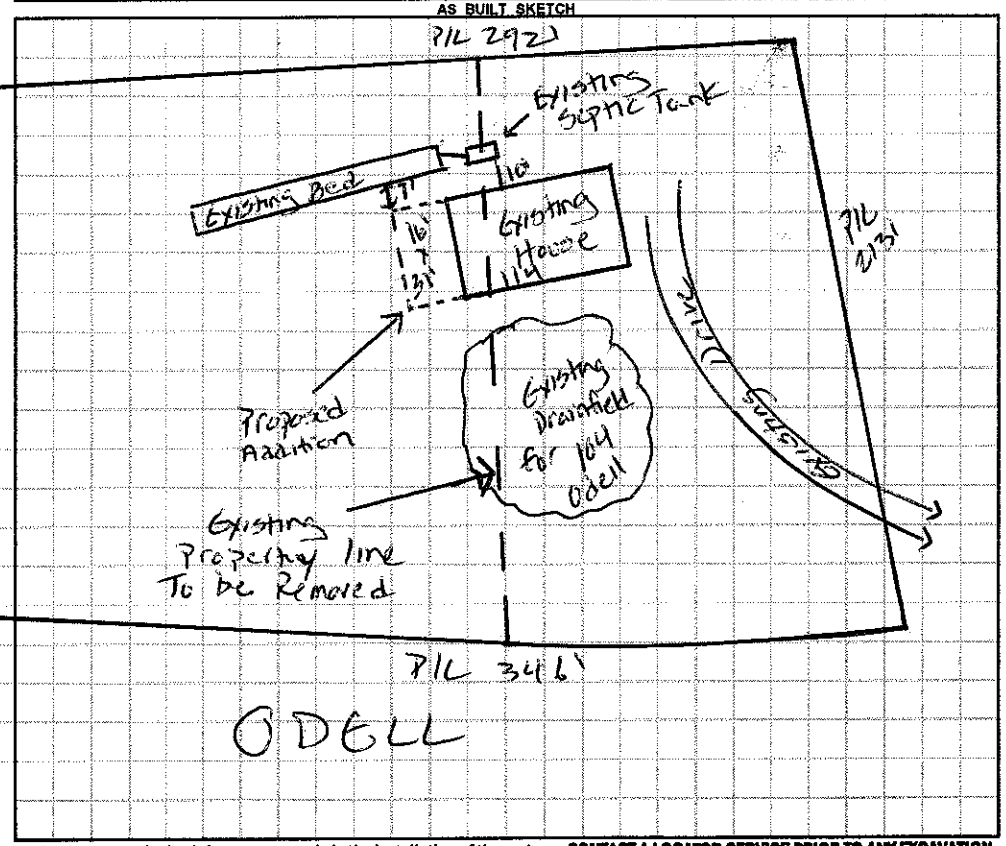

Permit can be suspended or revoked if any false information is supplied toward securing the permit / any unauthorized changes are made to the site / any unauthorized changes are made in the installation of the system. **CONTACT A LOCATOR SERVICE PRIOR TO ANY EXCAVATION**

☐ **IMPROVEMENT PERMIT** *with plat valid without expiration.* ☐ **IMPROVEMENT PERMIT** *with site plan valid for 60 mos.* ☐ **AUTHORIZATION TO CONSTRUCT** *valid for period equal to IMPROVEMENT PERMIT--not to exceed 60 mo.*

Owner / Applicant Signature: _____ Date: _____ Installed by: _____

IMPROVEMENT PERMIT by: _____ Date: _____ OPERATION PERMIT by: _____ Date: _____

AUTHORIZATION TO CONSTRUCT by: _____ Date: _____ Existing System Inspected by: _____ Date: 07/06/16

Health Dept. Copy - WHITE Applicant (Final Approval) - YELLOW Applicant (Conditional Approval) - PINK