IREDELL COUNTY HEALTH DEPARTMENT

STATESVILLE 704-878-5305 (C) MOORESVILLE 704-664-5281

IMPROVEMENT PERMIT / AUTHORIZATION TO CONSTRUCT / OPERATION PERMIT / EXISTING SYSTEM INSPECTION

PERMIT# 87446 PIN# ~~4706337693~~ 4706-53-1864 DATE Feb 28 2000

OWNER OR CONTRACTOR Brent Murdock PHONE: Business 528 6969 Home

ADDRESS 368 Old Mtn Rd Statesville NC

LOCATION Hwy 90 W (R) Robertson (L) Ridge Run Lot on left in corner of Ridge & Robertson

SUBDIVISION Ridgewest BLOCK / SECTION LOT 7 LOT AREA 1.20 AC SITE CLASS. PS DESIGN FLOW 360 L.T.A.R. .03

Septic Tank: 1000 Gallons; STB 160 Date 11-18-02
Pump Tank: Gallons; PT Date
Pump Make: Model Serial No.
Nitrification Field: No Fields 1 Square Feet 1200 Linear Feet 300
No Lines 4 Trench Width 36" Max Trench Bottom Depth 36"

☐ New System ☐ Repair System Type: I, II, (III), IV, V, VI
System Description: GRAVITY 25% Reduction
Repair System Description: pump / Reduction Poss.ble
Maintenance Agreement Required: ☐ Yes ☒ No

☒ House/Mod. Home No. Bedrooms 3
☐ Mobile Home No. Bathrooms 2
☐ Business No. Employees
☐ Other


Water Supply: ☐ Individual ☒ Public ☐ Community

☐ Slab ☒ Crawl Space ☐ Basement w/plumbing ☐ Basement wo/plumbing


Comments:/Conditions: INSTALL on CONTOUR
50 chambers OR 30 HAS sections
1" x 40ft Scale

Comments:/Conditions: SEPTIC TANK WITH MARKER INSTALLED
USING "ZABEL" FILTER & SYSTEM
INSTALLED USING 50 "INFILTRATOR" CHAMBERS
DURING PERIOD OF WET SOIL CONDITIONS

INITIAL SITE SKETCH

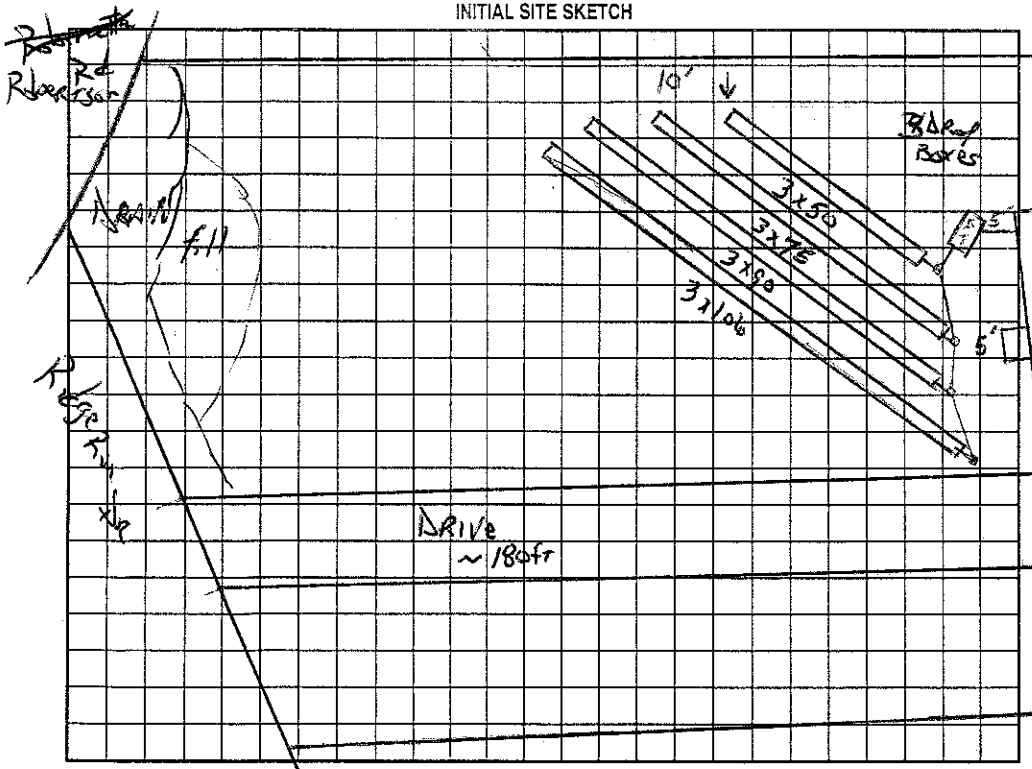

AS BUILT SKETCH

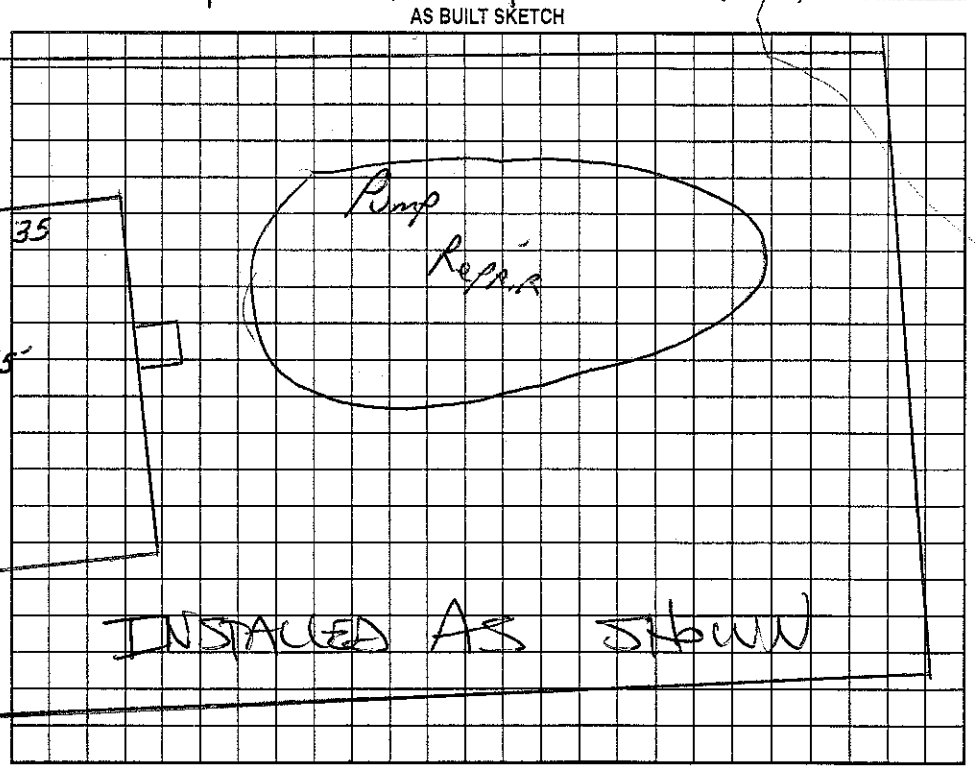

Permit can be suspended or revoked if any false information is supplied toward securing the permit/any unauthorized changes are made to the site/any unauthorized changes are made in the installation of the system. Improvement Permit ~~with plat~~ valid without expiration. Improvement Permit with site plan valid for sixty months. Authorization to Construct is valid for a period equal to that of Improvement Permit – not to exceed sixty months.

Signed: [signature] date 3-1-00 Installed by: L & E GRADING

Improvement Permit by: J. C. Potter date Feb 28 2000 Operation Permit by: STEVE HENDRICK date 4-9-03

Authorization to Construct by: J. C. Potter date Feb 28 2000 Existing System Inspection by: date

HEALTH DEPT. COPY: WHITE OWNER COPY (FINAL): YELLOW OWNER COPY (INITIAL): PINK